



U.S. Department
of Transportation
**Federal Aviation
Administration**

Alaskan Region Airports Division

222 W. 7th Avenue, #14
Anchorage, Alaska 99513-7587
Tel. (907) 271-5438 / Fax (907) 271-2851

May 22, 2020

Virginia Groeschel
ADOT&PF Aviation Design
4111 Aviation Ave
Anchorage, AK 99519-6900

Dear Ms. Groeschel:

Talkeetna Airport

**Talkeetna, Alaska
As-Built Airport Layout Plan (20 May 2020)
(Original ALP Airspace #2009-AAL-81-NRA)**



We have completed our review of the Talkeetna Airport As-Built Airport Layout Plan (ALP) dated 20 May 2020, and find it acceptable for documenting the existing conditions of the airport.

Please retain this letter in your files for future reference.

Sincerely,

Pat Zettler, P.E., Lead Engineer
Airports Division

Designed By: LEU
 Drawn By: AUC
 Checked By: MMG
 Date Plotted: 5/20/2020, 4:50 PM
 Product Number: 0000
 File Name: U:\2019\02282\Talkeetna\Drawings\ALP-TKA-1-2_COVER-DATA.dwg

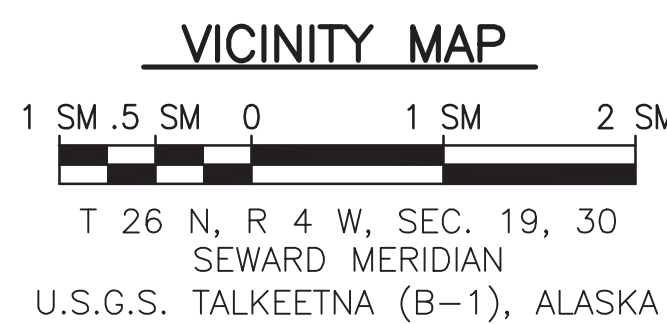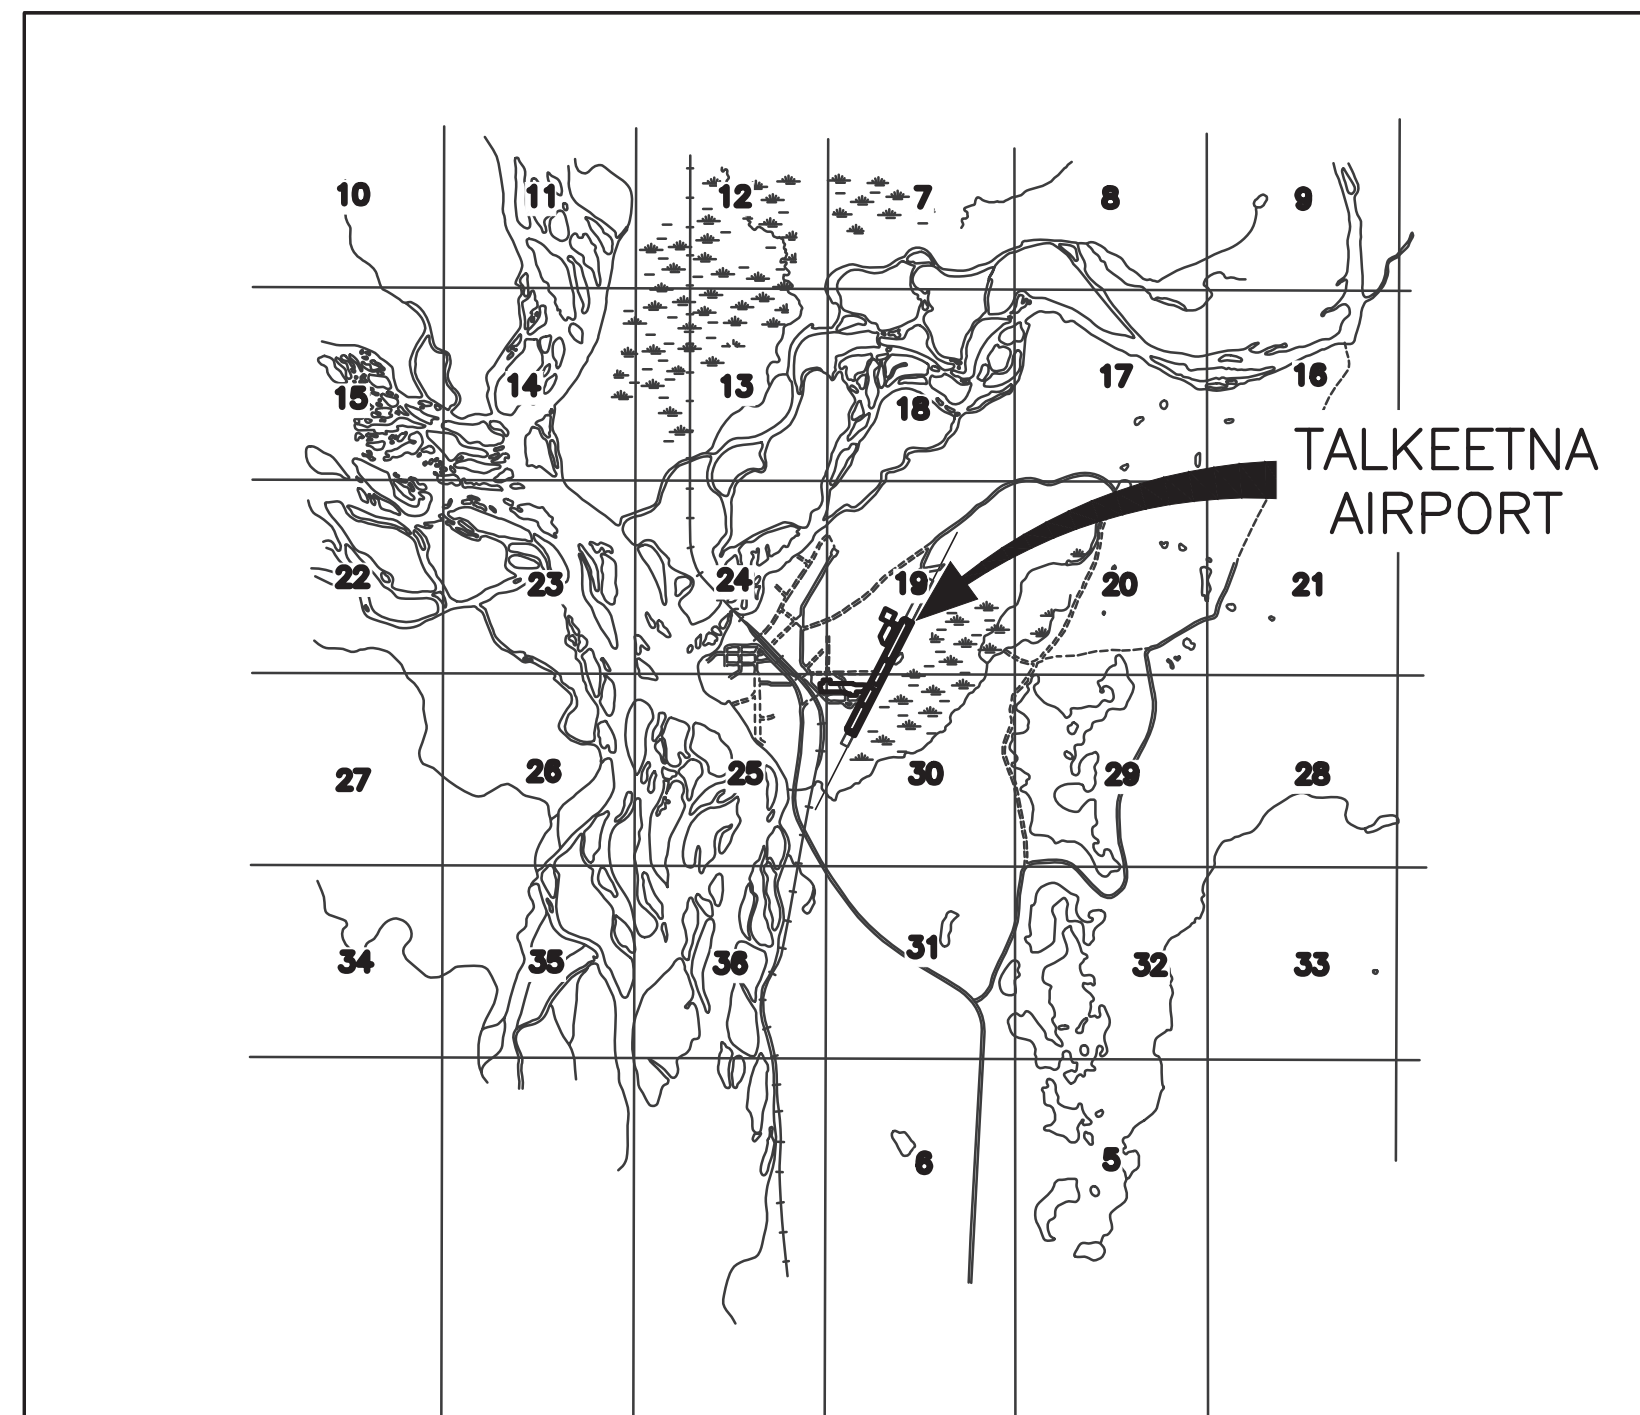

TALKEETNA AIRPORT AIRPORT LAYOUT PLAN

TALKEETNA, ALASKA

LEGEND		
ITEM	EXISTING	ULTIMATE
AIRPORT REFERENCE POINT (A.R.P.)		
ANTENNA		
APPROACH SURFACE		
BUILDINGS		
BUILDING RESTRICTION LINE		
DEPARTURE SURFACE		
FAA WEATHER STATION		
FENCE		
LIGHT POLE		
NON-DIRECTIONAL BEACON		
OBSTACLE CLEARANCE SURFACE		
OVERHEAD ELECTRICAL LINE		
PAPI		
PROPERTY LINE		
RAILROAD		
REIL		
ROADWAYS - PAVED		
ROADWAYS - UNPAVED		
ROTATING BEACON		
RUNWAY OBJECT FREE AREA		
RUNWAY OBSTACLE FREE ZONE		
RUNWAY PROTECTION ZONE		
RUNWAY SAFETY AREA		
SEGMENTED CIRCLE		
SHORELINE		
SURVEY MONUMENT		
TAXIWAY EDGE LIGHT		
THRESHOLD MARKERS/LIGHTS		
THRESHOLD SITING SURFACE		
TOPOGRAPHIC CONTOURS		
TREELINE		
UTILITY POLE		
VASI		
WATER BODY		
WIND CONE		


DRAWING INDEX	
SHT #	SHEET TITLE
1	COVER SHEET & INDEX
2	AIRPORT DATA
3	EXISTING LAYOUT (1 OF 2)
4	EXISTING LAYOUT (2 OF 2)
5	ULTIMATE LAYOUT (1 OF 2)
6	ULTIMATE LAYOUT (2 OF 2)
7	EXISTING/ULTIMATE RUNWAY PROFILES
8	EXISTING TERMINAL AREA (1 OF 2)
9	EXISTING TERMINAL AREA (2 OF 2)
10	ULTIMATE TERMINAL AREA (1 OF 2)
11	ULTIMATE TERMINAL AREA (2 OF 2)
12	EXISTING INNER PORTION OF THE APPROACH SURFACE - RUNWAY 1-19
13	ULTIMATE INNER PORTION OF THE APPROACH SURFACE - RUNWAY 1-19
14	ULTIMATE INNER PORTION OF THE APPROACH SURFACE - HELIPORT
15	EXISTING DEPARTURE SURFACES - RUNWAY 1-19
16	ULTIMATE DEPARTURE SURFACES - RUNWAY 1-19
17	AIRPORT AIRSPACE (F.A.R. PART 77)
18	AIRPORT AIRSPACE PROFILES (F.A.R. PART 77) RUNWAY 1-19 AND HELIPORT
19	LAND USE
20	PROPERTY MAP

BY	DATE	REVISION

APPROVED: _____ **DATE:** _____
JOHN LINNELL, P.E. PRECONSTRUCTION ENGINEER
RECOMMENDED: _____ **DATE:** _____
LUKE BOWLAND, P.E. AVIATION DESIGN GROUP CHIEF
 AIRPORT LAYOUT PLAN CONDITIONAL APPROVAL SUBJECT TO
 ALP APPROVAL LETTER DATED 9/16/2010
 FAA AIRSPACE REVIEW NUMBER: 2009-AAL-81-NRA
PATRICK J ZETTLER Digitally signed by PATRICK J ZETTLER
 Date: 2020.05.22 15:52:54
ZETTLER **As-Built Accepted** **DATE:** _____
FAA, AIRPORTS DIVISION ALASKAN REGION, AAL-

STATE OF ALASKA
DEPARTMENT OF TRANSPORTATION
AND PUBLIC FACILITIES
CENTRAL REGION
TALKEETNA AIRPORT
 TALKEETNA, ALASKA
AIRPORT LAYOUT PLAN
 COVER & SHEET INDEX
DATE: 5/20/2020
SHEET: 1 OF 20

Date: 15/19/2020, 12:59 PM
 User: D:\Users\jgarcia\Documents\Projects\Talkeetna\Drawings\ALP\1-2_COVER-DATA.dwg
 Layer: DATA
 File Name: U:\2019\02\28\Talkeetna\Drawings\ALP\1-2_COVER-DATA.dwg

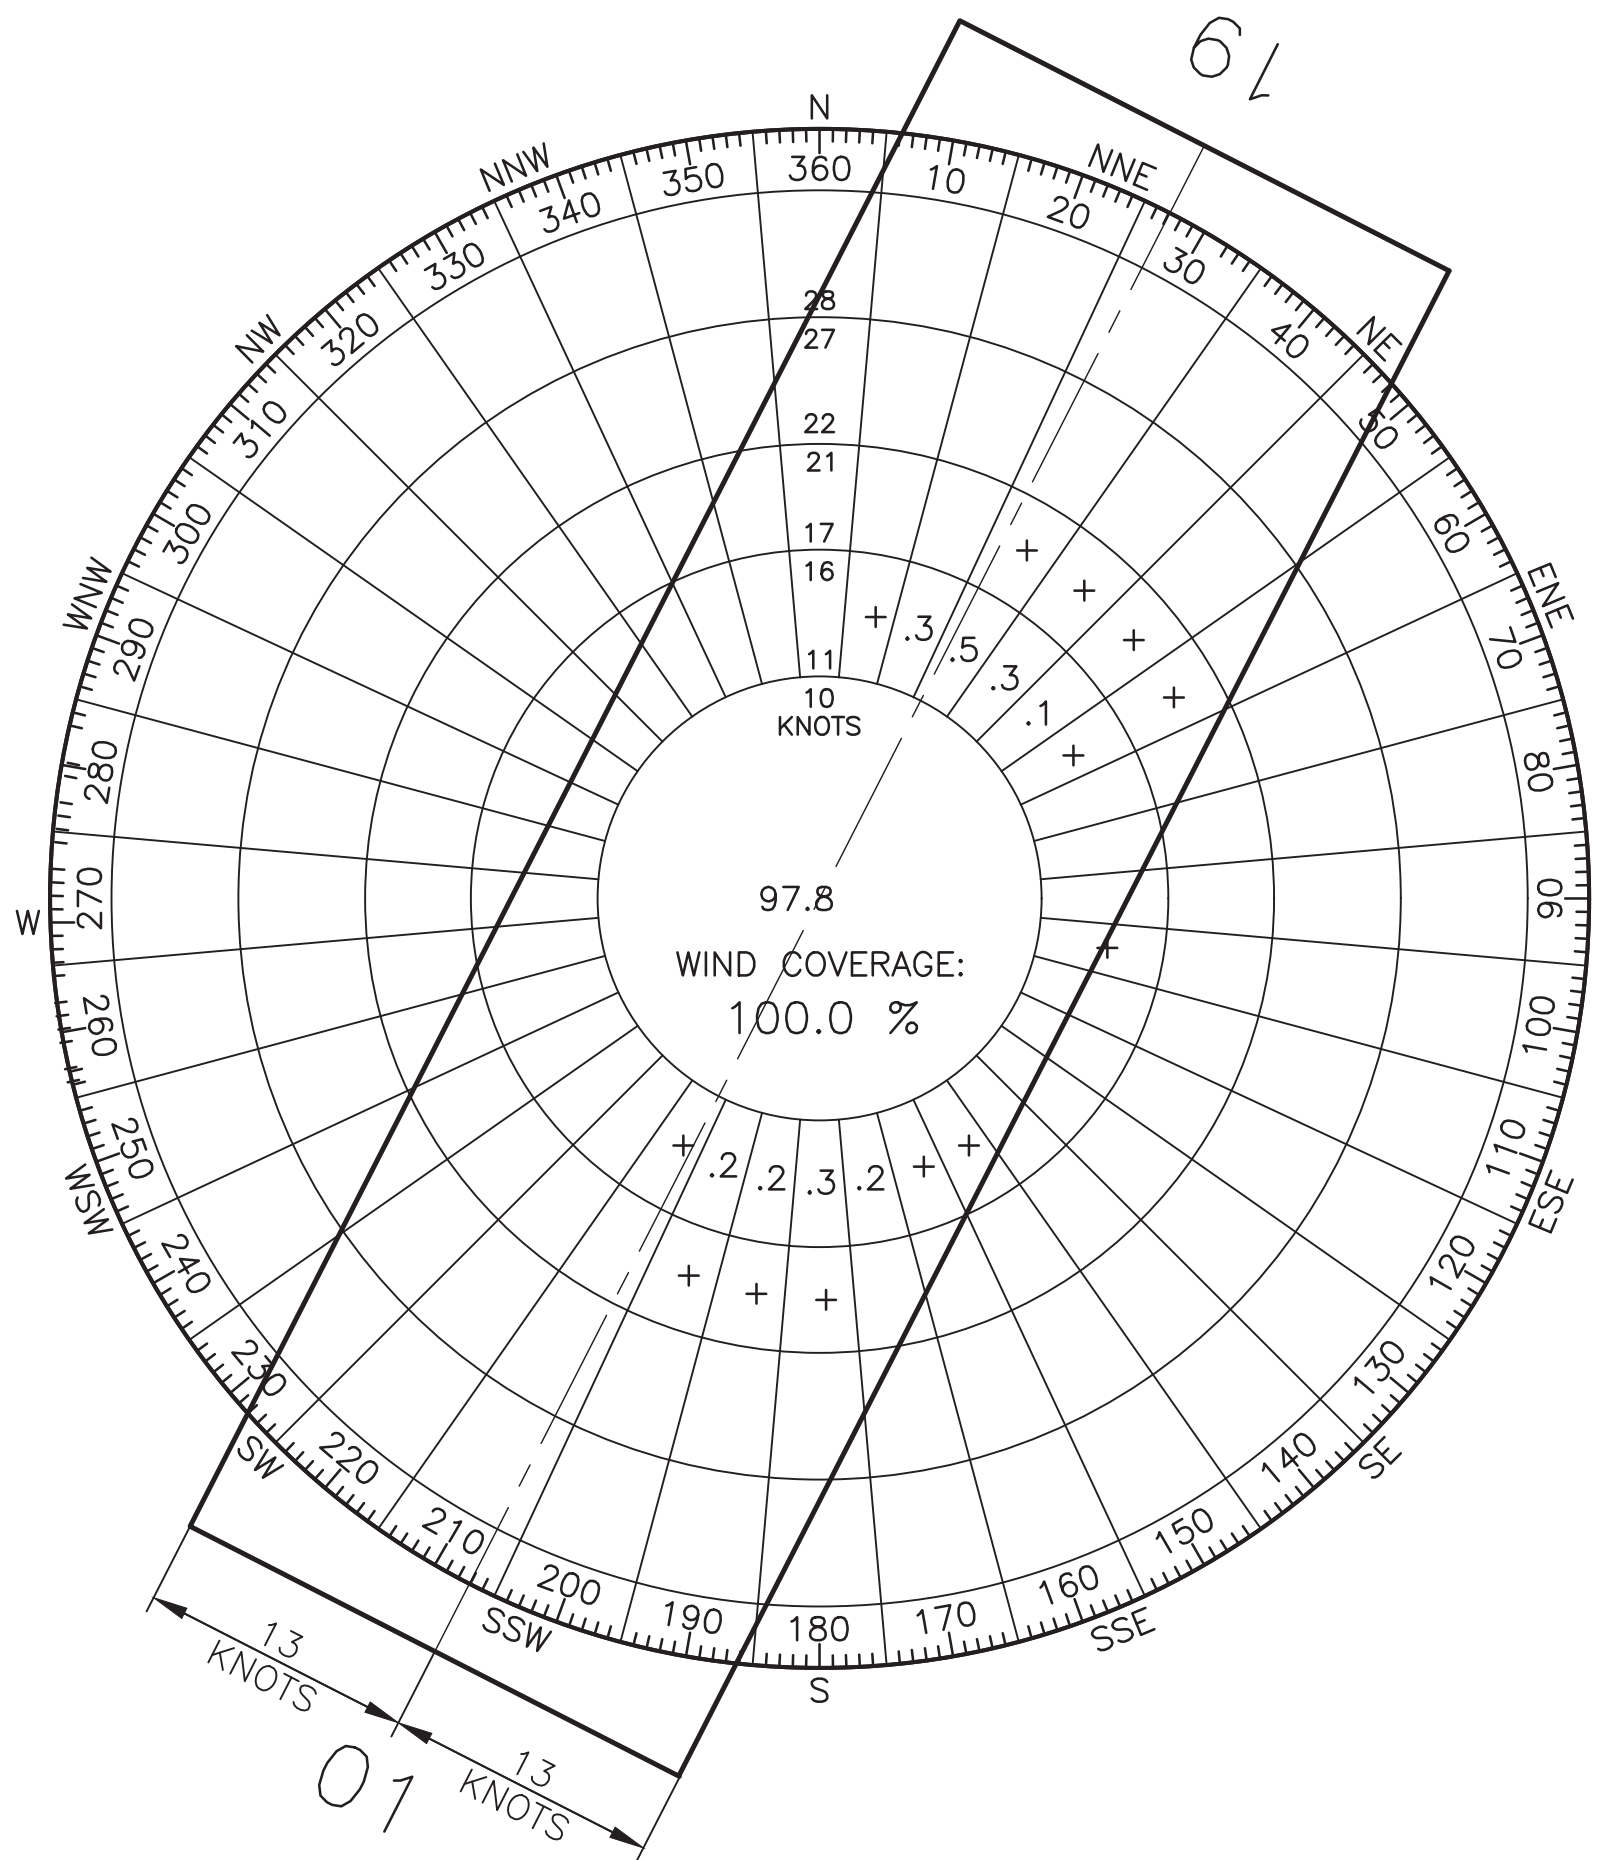


WIND DATA

NOTE: WIND SPEED IS INDICATED IN KNOTS.

RUNWAY	10.5 kt	13 kt
1/19	99.97%	100.0%

SOURCE: FAA GIS NATION CLIMATIC DATA CENTER
 STATION: TALKEETNA, AK
 PERIOD: 2009-2018

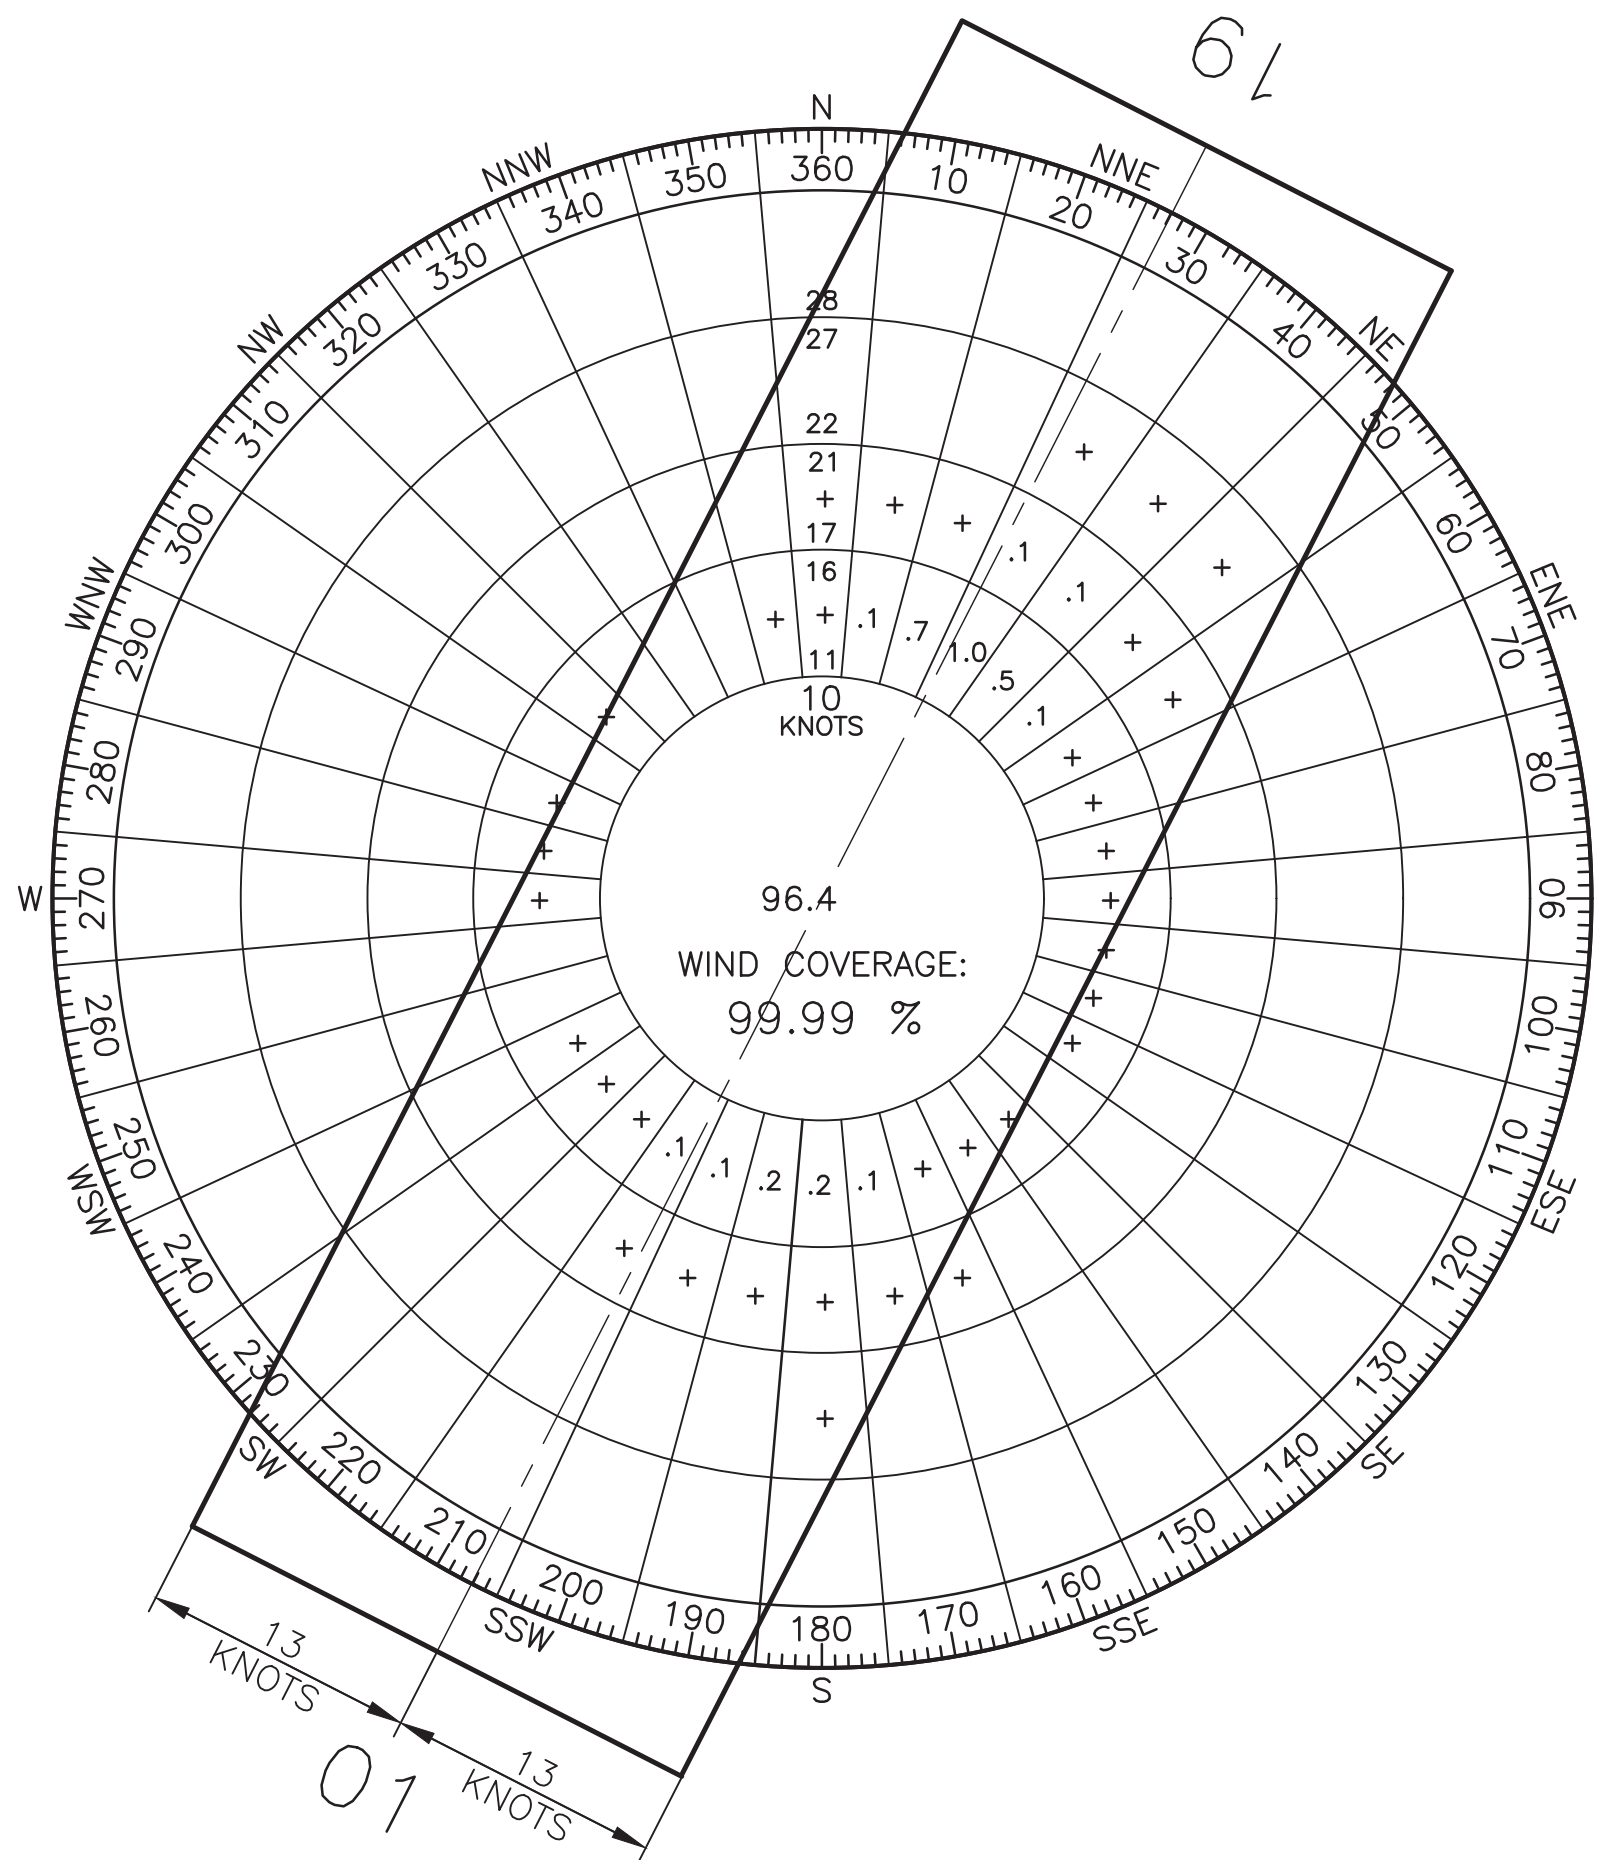

WIND DATA

NOTE: WIND SPEED IS INDICATED IN KNOTS.

RUNWAY	10.5 kt	13 kt
1/19	99.95%	99.99%

SOURCE: FAA GIS NATION CLIMATIC DATA CENTER
 STATION: TALKEETNA, AK
 PERIOD: 2009-2018

- NOTES:**
- THIS DRAWING CONSISTS OF FAA AIRPORTS-GIS SURVEY DATA COMPILED IN SUPPORT OF AS-BUILT AERONAUTICAL SURVEY #234932.
 - THE HORIZONTAL COORDINATE SYSTEM IS NAD83 (2011) (EPOCH 2010) ALASKA STATE PLANE ZONE 4, IN U.S. SURVEY FEET. THE VERTICAL DATUM FOR THIS PROJECT IS NAVD88 USING GEOID12B.
 - ROUND SURVEY WAS PERFORMED BY STANTEC DURING AUGUST 1-7, 2018. NO AERIAL MAPPING WAS PERFORMED THIS SURVEY.
 - PACS AND SACS POSITIONS SHOWN HEREIN ARE BASED ON NATIONAL GEODETIC SURVEY (NGS) PUBLISHED POSITIONS, HAVING BEEN FIELD VERIFIED BY STANTEC.

PID	DESIGNATION	LATITUDE	LONGITUDE	ELLIPSOID HEIGHT	NORTHING	EASTING	ELEVATION	DESCRIPTION
DQ2908	TKA D	62°19'13.24" N	150°05'45.33" W	385.3'	3040111.5	1624101.5	353.1'	PACS
DQ2909	TKA E	62°19'01.44" N	150°05'58.75" W	382.1'	3038913.8	1623465.5	349.9'	SACS
DQ2910	TKA F	62°19'30.92" N	150°05'26.37" W	392.7'	3041905.6	1624999.4	360.3'	SACS

ITEM	EXISTING LATITUDE	EXISTING LONGITUDE	EXISTING STATION	EXISTING ELEVATION	ULTIMATE LATITUDE	ULTIMATE LONGITUDE	ULTIMATE STATION	ULTIMATE ELEVATION
ARP	62°19'16.94" N	150°05'33.78" W	N/A	N/A	62°19'16.94" N	150°05'33.78" W	N/A	N/A
THRESHOLD RW 01	62°19'01.60" N	150°05'50.64" W	3+00	356.1'	62°19'01.60" N	150°05'50.64" W	3+00	356.1'
THRESHOLD RW 19	62°19'32.28" N	150°05'16.93" W	38+00	365.0'	62°19'32.28" N	150°05'16.93" W	38+00	365.0'
HELIPORT REFERENCE POINT	N/A	N/A	N/A	N/A	62°19'48.67" N	150°04'38.38" W	N/A	366.4'

ITEM	EXISTING	STANDARD	ULTIMATE	AIRSPACE #	APPROVAL DATE
NONE					

ITEM	EXISTING	ULTIMATE
ICAO IDENTIFIER	PATK	PATK
NATIONAL AIRPORT IDENTIFIER	TKA	TKA
FAA SITE NUMBER	50738.*A	50738.*A
AIRPORT ELEVATION NAVD88	365.0'	365.0'
AIRPORT REFERENCE CODE	B-II(S)	B-II(S)
CRITICAL AIRCRAFT	B-II(S)	B-II(S)
MEAN MAX. TEMPERATURE, HOTTEST MONTH	68.0°F, JULY	68.0°F, JULY
MAGNETIC DECLINATION, YEAR, RATE OF CHANGE	14°29'E, JAN 2025, 16' WEST PER YEAR	
AIRPORT AND TERMINAL NAVIGATION AIDS	VOR, NDB, GPS, DME, ROTATING BEACON	VOR, NDB, GPS, DME, ROTATING BEACON
MISCELLANEOUS FACILITIES	WINDCONE, FAA WEATHER STATION	WINDCONE, FAA WEATHER STATION
NPIAS SERVICE LEVEL	GENERAL AVIATION	GENERAL AVIATION
STATE EQUIVALENT SERVICE ROLE	COMMUNITY ON-ROAD	COMMUNITY ON-ROAD

ITEM	EXISTING	ULTIMATE
RUNWAY IDENTIFIER	01/19	01/19
RUNWAY TYPE (UTILITY OR OTHER THAN UTILITY)	UTILITY	UTILITY
FAR PART 77 APPROACH CATEGORY (V, NPI, P)	NPI / NPI	NPI / NPI
FAR PART 77 APPROACH SURFACE SLOPE	20:1 / 20:1	20:1 / 20:1
THRESHOLD SITING SURFACE	20:1 / 20:1	20:1 / 20:1
DEPARTURE SURFACE	YES / YES	YES / YES
VISIBILITY MINIMUM	≥1 SM	≥1 SM
RUNWAY SURFACE	ASPHALT	ASPHALT
AIRPLANE GEAR CONFIG/PAVE STRENGTH x1000lbs	SINGLE / 30	SINGLE / 30
PAVEMENT STRENGTH BY PCN		
SURFACE TREATMENT	NONE	NONE
RUNWAY DESIGN CODE	B-II(S)	B-II(S)
APPROACH REFERENCE CODE	B/II/5000	B/II/5000
DEPARTURE REFERENCE CODE	B/II	B/II
DESIGN GROUP OR AIRCRAFT IF > 60,000 lbs	N/A	N/A
MEAN GEODETIC BEARING	N 27°04'07.94" E	N 27°04'07.94" E
MAXIMUM ELEVATION (NAVD88)	365.0'	365.0'
EFFECTIVE GRADE	0.25%	0.25%
TOUCHDOWN ZONE ELEVATION NAVD88	363.2' / 365.0'	363.2' / 365.0'
RUNWAY DIMENSIONS	75' x 3,500'	75' x 3,500'
RUNWAY SAFETY AREA (RSA)	150' x 4,100'	150' x 4,100'
RSA LENGTH BEYOND RUNWAY ENDS	300'	300'
RUNWAY PROTECTION ZONE (RPZ)	250' x 450' x 1,000'	250' x 450' x 1,000'
RUNWAY OBJECT FREE AREA (OFA)	500' x 4,100'	500' x 4,100'
OFA LENGTH BEYOND RUNWAY ENDS	300'	300'
RUNWAY OBSTACLE FREE ZONE (OFZ)	250' x 3,900'	250' x 3,900'
PRECISION OBSTACLE FREE ZONE (POFZ)	N/A	N/A
RUNWAY LIGHTING	MIRL	MIRL
RUNWAY MARKING TYPE	NPA	NPA
RUNWAY NAVIGATIONAL AIDS	VASI, GPS VOR, DME, NDB	PAPI, GPS, VOR, DME, NDB
AERONAUTICAL SURVEY TYPE REQUIRED	VG	VG

ITEM	TW A		TW B		TW C		TW D		TW E		TW F		TW G		TW H		TW J	
	EXISTING	ULTIMATE	EXISTING	ULTIMATE	EXISTING	ULTIMATE	EXISTING	ULTIMATE	EXISTING	ULTIMATE	EXISTING	ULTIMATE	EXISTING	ULTIMATE	EXISTING	ULTIMATE	EXISTING	ULTIMATE
AIRPLANE DESIGN GROUP	II	II	II	II	II	II	II	II	II	II	II	II	II	II	II	II	II	II
TAXIWAY DESIGN GROUP	2	2	2	2	2	2	2	2	2	2	2	2	2	2	2	2	2	2
TAXIWAY SURFACE	ASPHALT	ASPHALT	ASPHALT	ASPHALT	ASPHALT	ASPHALT	ASPHALT	ASPHALT	ASPHALT	ASPHALT	ASPHALT	ASPHALT	ASPHALT	ASPHALT	ASPHALT	ASPHALT	ASPHALT	ASPHALT
TAXIWAY DIMENSIONS	35' X 3,900'	35' X 3,900'	35' X 202'	35' X 202'	35' X 202'	35' X 202'	35' X 202'	35' X 202'	35' X 202'	35' X 202'	35' X 100'	35' X 100'	35' X 100'	35' X 100'	35' X 250'	35' X 250'	35' X 250'	35' X 250'
SHOULDER WIDTH	10'	10'	10'	10'	10'	10'	10'	10'	10'	10'	10'	10'	10'	10'	10'	10'	10'	10'
SAFETY AREA (TSA) WIDTH	79'	79'	79'	79'	79'	79'	79'	79'	79'	79'	79'	79'	79'	79'	79'	79'	79'	79'
EDGE SAFETY MARGIN (TESM)	7.5'	7.5'	7.5'	7.5'	7.5'	7.5'	7.5'	7.5'	7.5'	7.5'	7.5'	7.5'	7.5'	7.5'	7.5'	7.5'	7.5'	7.5'
OBJECT FREE AREA (TOFA) WIDTH	131'	131'	131'	131'	131'	131'	131'	131'	131'	131'	131'	131'	131'	131'	131'	131'	131'	131'
TAXIWAY LIGHTING	MITL	MITL	MITL	MITL	MITL	MITL	MITL	MITL	MITL	MITL	MITL	MITL	MITL	MITL	MITL	MITL	MITL	MITL
TAXIWAY MARKING	YES	YES	YES	YES	YES	YES	YES	YES	YES	YES	YES	YES	YES	YES	NO	NO	NO	NO

BY	DATE	REVISION


**STATE OF ALASKA
DEPARTMENT OF TRANSPORTATION
AND PUBLIC FACILITIES
CENTRAL REGION**

TALKEETNA AIRPORT
TALKEETNA, ALASKA
AIRPORT LAYOUT PLAN

DATE: 5/19/2020
SHEET: 2 OF 20

Date Plotted: 15/19/2020, 1:02 PM
 Layout Name: 3 EXISTING LAYOUT
 File Name: U:\2019\2020\Talkeetna\Drawings\ALP-1-1-ALP_2019\Sheet3\ALP-TWA-3-6-EX-N-ILL-LAYOUTS.dwg


Designed By: LEN
 Drawn By: ADC
 Checked By: MUG

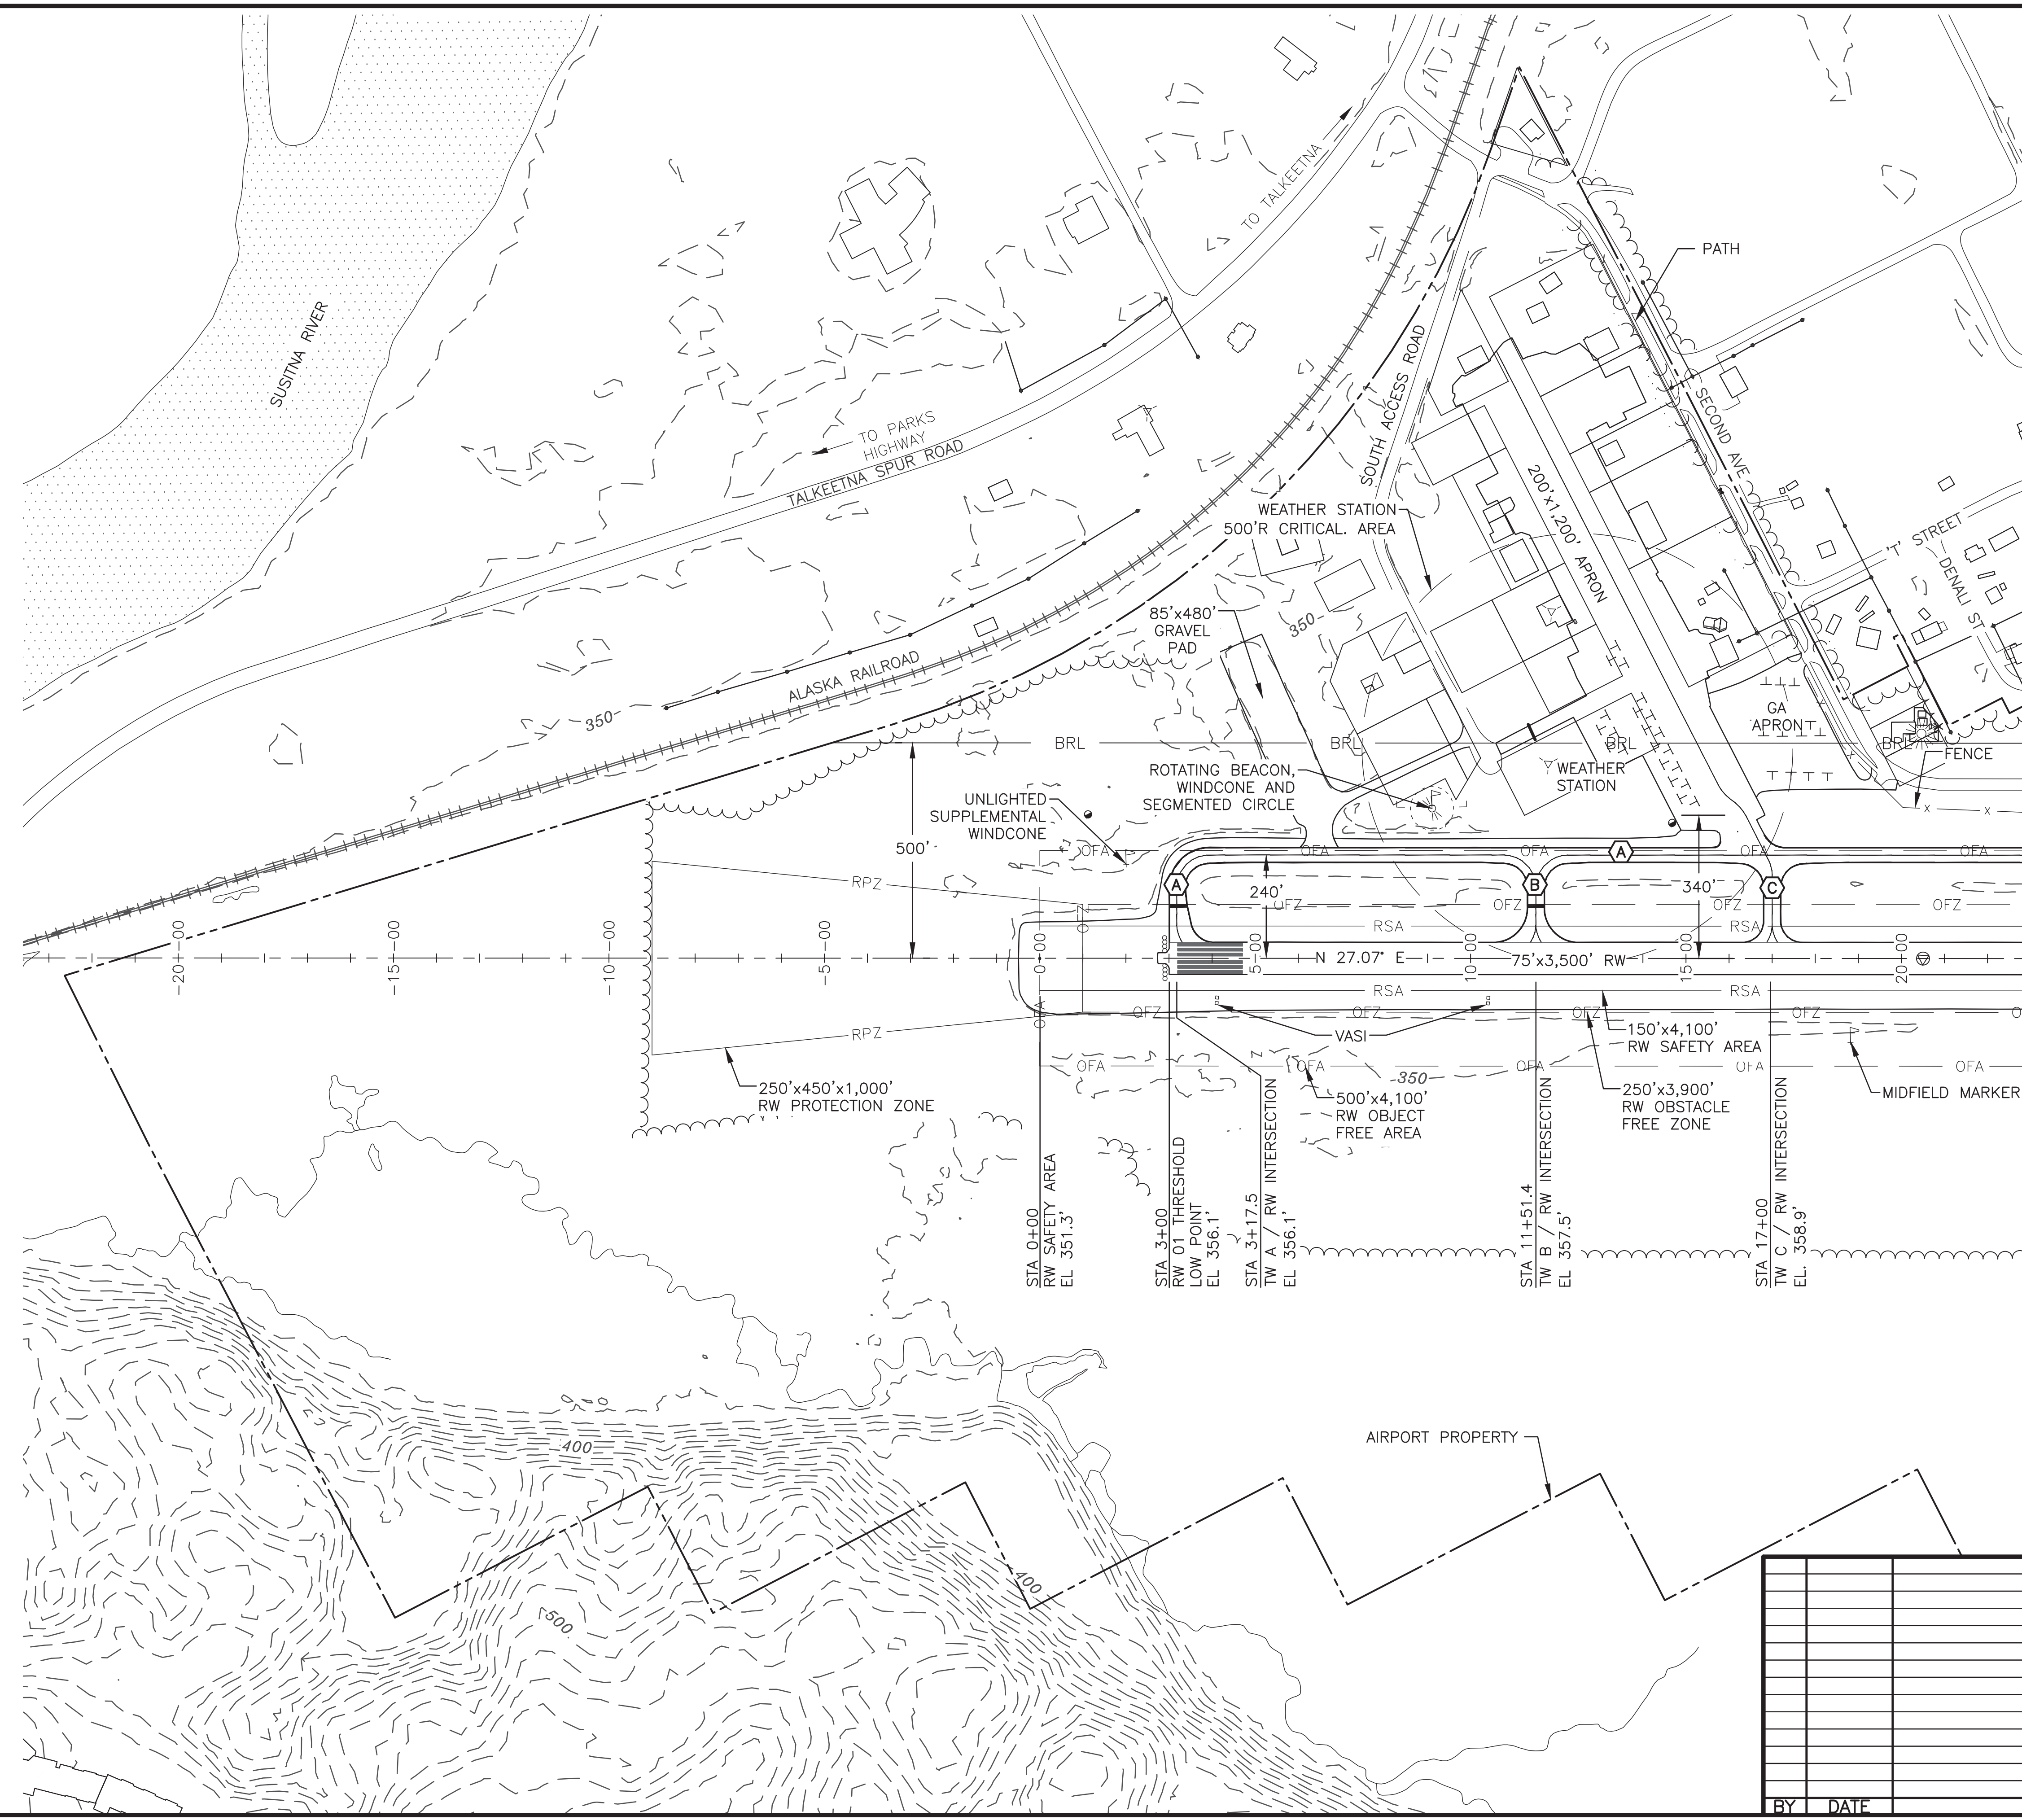

TAXIWAY DATA TABLE				
ITEM	EXISTING			
	WIDTH	LENGTH	TSA	TOFA
TW A	35'	3,900'	79'	131'
TW B	35'	202'	79'	131'
TW C	35'	202'	79'	131'

- NOTES:**
- NO THRESHOLD SITING SURFACE OBJECT PENETRATIONS.
 - NO OFZ PENETRATIONS.

MATCH LINE RW 1-19 STA 23+00
 SEE SHEET 4

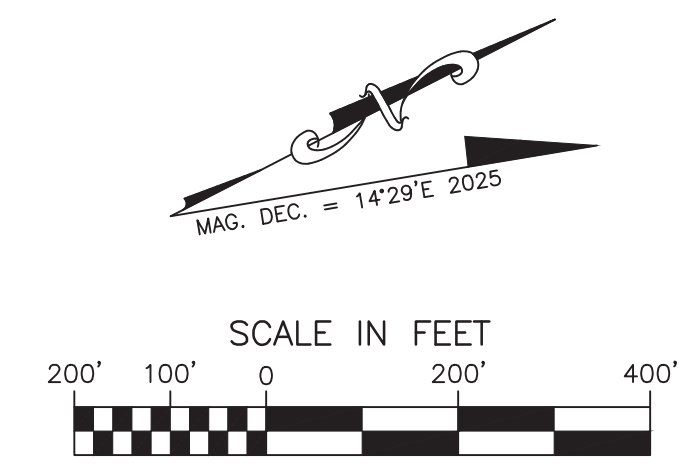

BY	DATE	REVISION

STATE OF ALASKA
DEPARTMENT OF TRANSPORTATION
AND PUBLIC FACILITIES
CENTRAL REGION

TALKEETNA AIRPORT
 TALKEETNA, ALASKA
 AIRPORT LAYOUT PLAN



EXISTING LAYOUT (1 OF 2)

DATE: 5/19/2020
 SHEET: 3 OF 20

Date Plotted: 15/19/2020, 3:11 PM
 Layout Name: 4 EXISTING LAYOUT
 File Name: U:\201700282\Talkeetna\AAs-Built-MIP-2019\Sheet3\MIP-TKA-3-6_EX-NI-UL-LAYOUTS.dwg
 Designer By: LEN
 Drawn By: ADC
 Checked By: MAG

ITEM	EXISTING			TOFA
	WIDTH	LENGTH	TSA	
TW A	35'	3,900'	79'	131'
TW D	35'	202'	79'	131'
TW E	35'	202'	79'	131'
TW F	35'	100'	79'	131'
TW G	35'	100'	79'	131'
TW H	35'	100'	79'	131'
TW J	35'	250'	79'	131'

- NOTES:**
- 1. NO THRESHOLD SITING SURFACE OBJECT PENETRATIONS.
 - 2. NO OFZ PENETRATIONS.

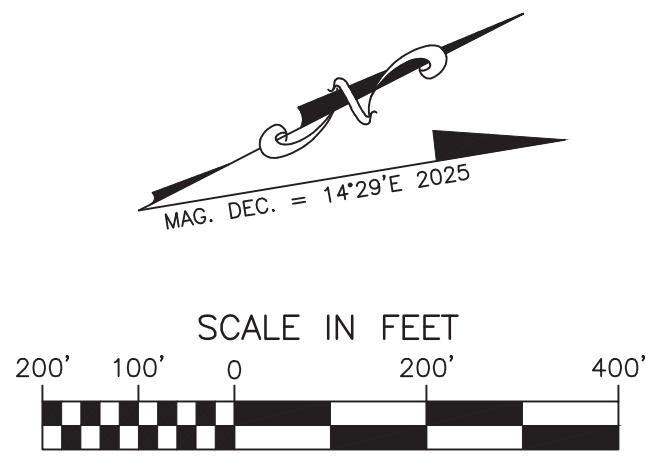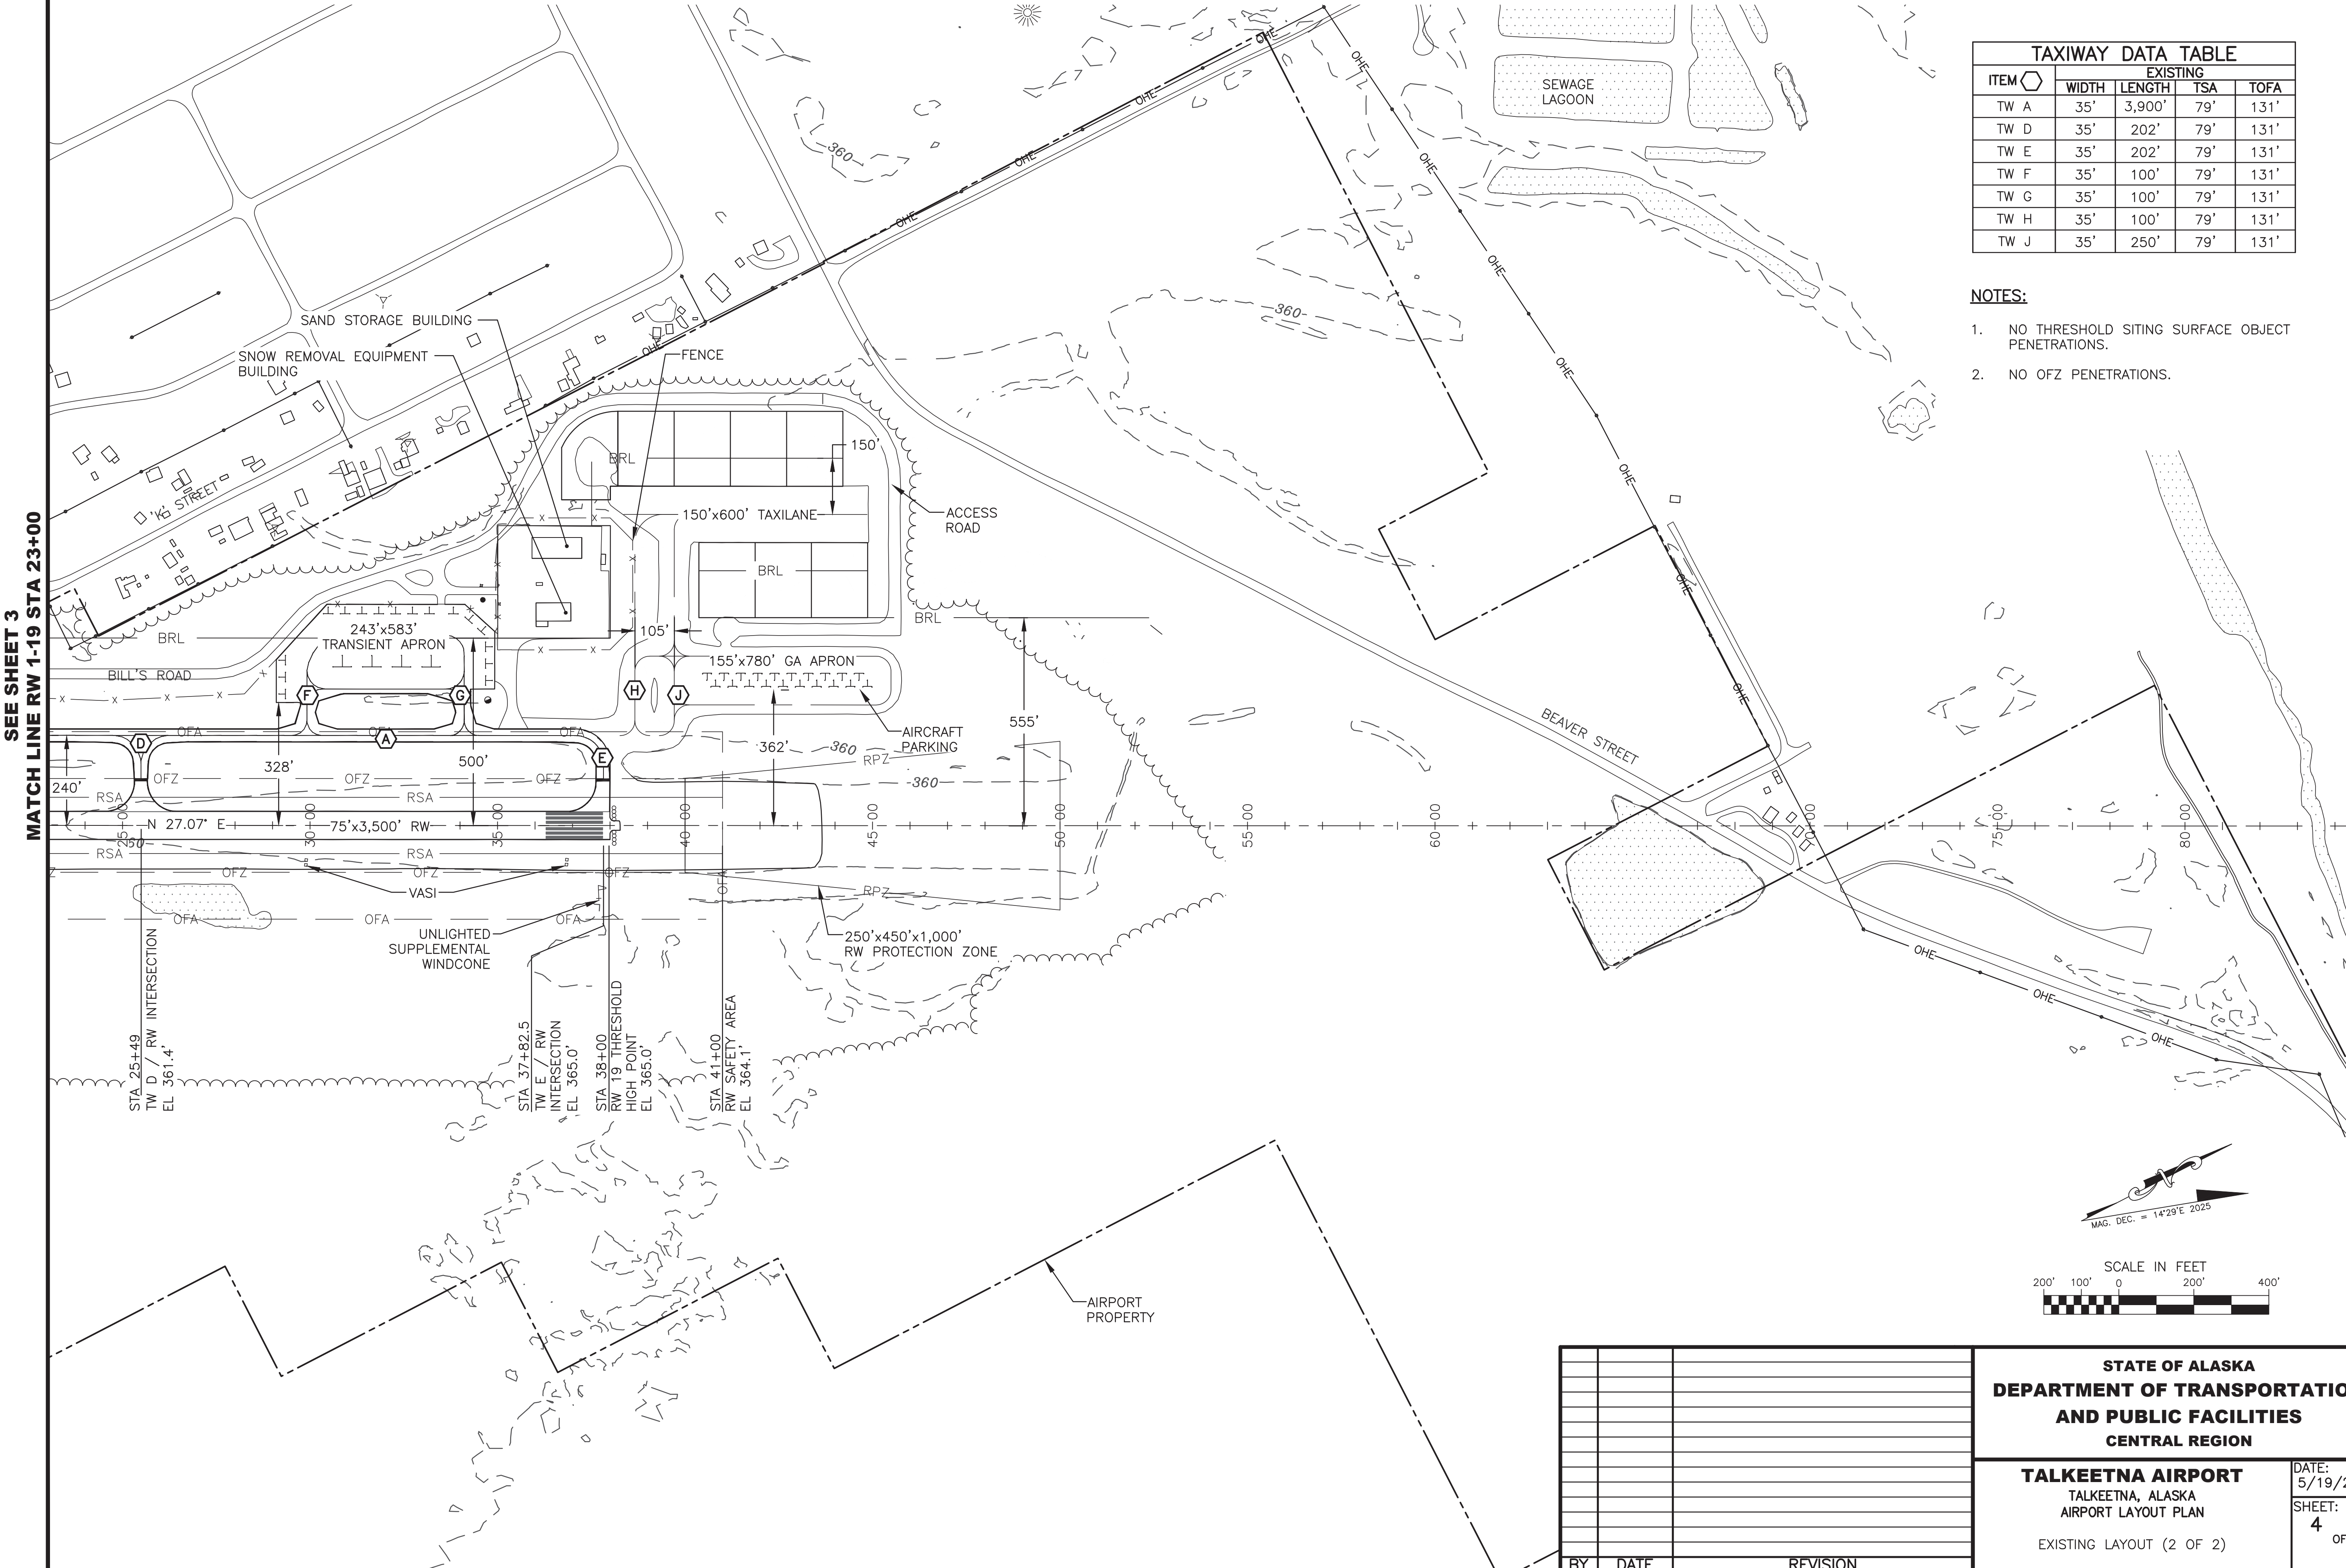

SEE SHEET 3
 MATCH LINE RW 1-19 STA 23+00

BY	DATE	REVISION


STATE OF ALASKA
DEPARTMENT OF TRANSPORTATION
AND PUBLIC FACILITIES
CENTRAL REGION

TALKEETNA AIRPORT
 TALKEETNA, ALASKA
 AIRPORT LAYOUT PLAN

EXISTING LAYOUT (2 OF 2)

DATE: 5/19/2020	SHEET: 4 OF 20
--------------------	-------------------------


Designed By: LEN
 Drawn By: ADC
 Checked By: MMS
 Date Plotted: 15/19/2020 1:03 PM
 User Name: U:\2019\2020\TALKEETNA AIRPORT LAYOUT\ULTIMATE_LAYOUT.dwg
 File Name: U:\2019\2020\TALKEETNA AIRPORT LAYOUT\ULTIMATE_LAYOUT.dwg

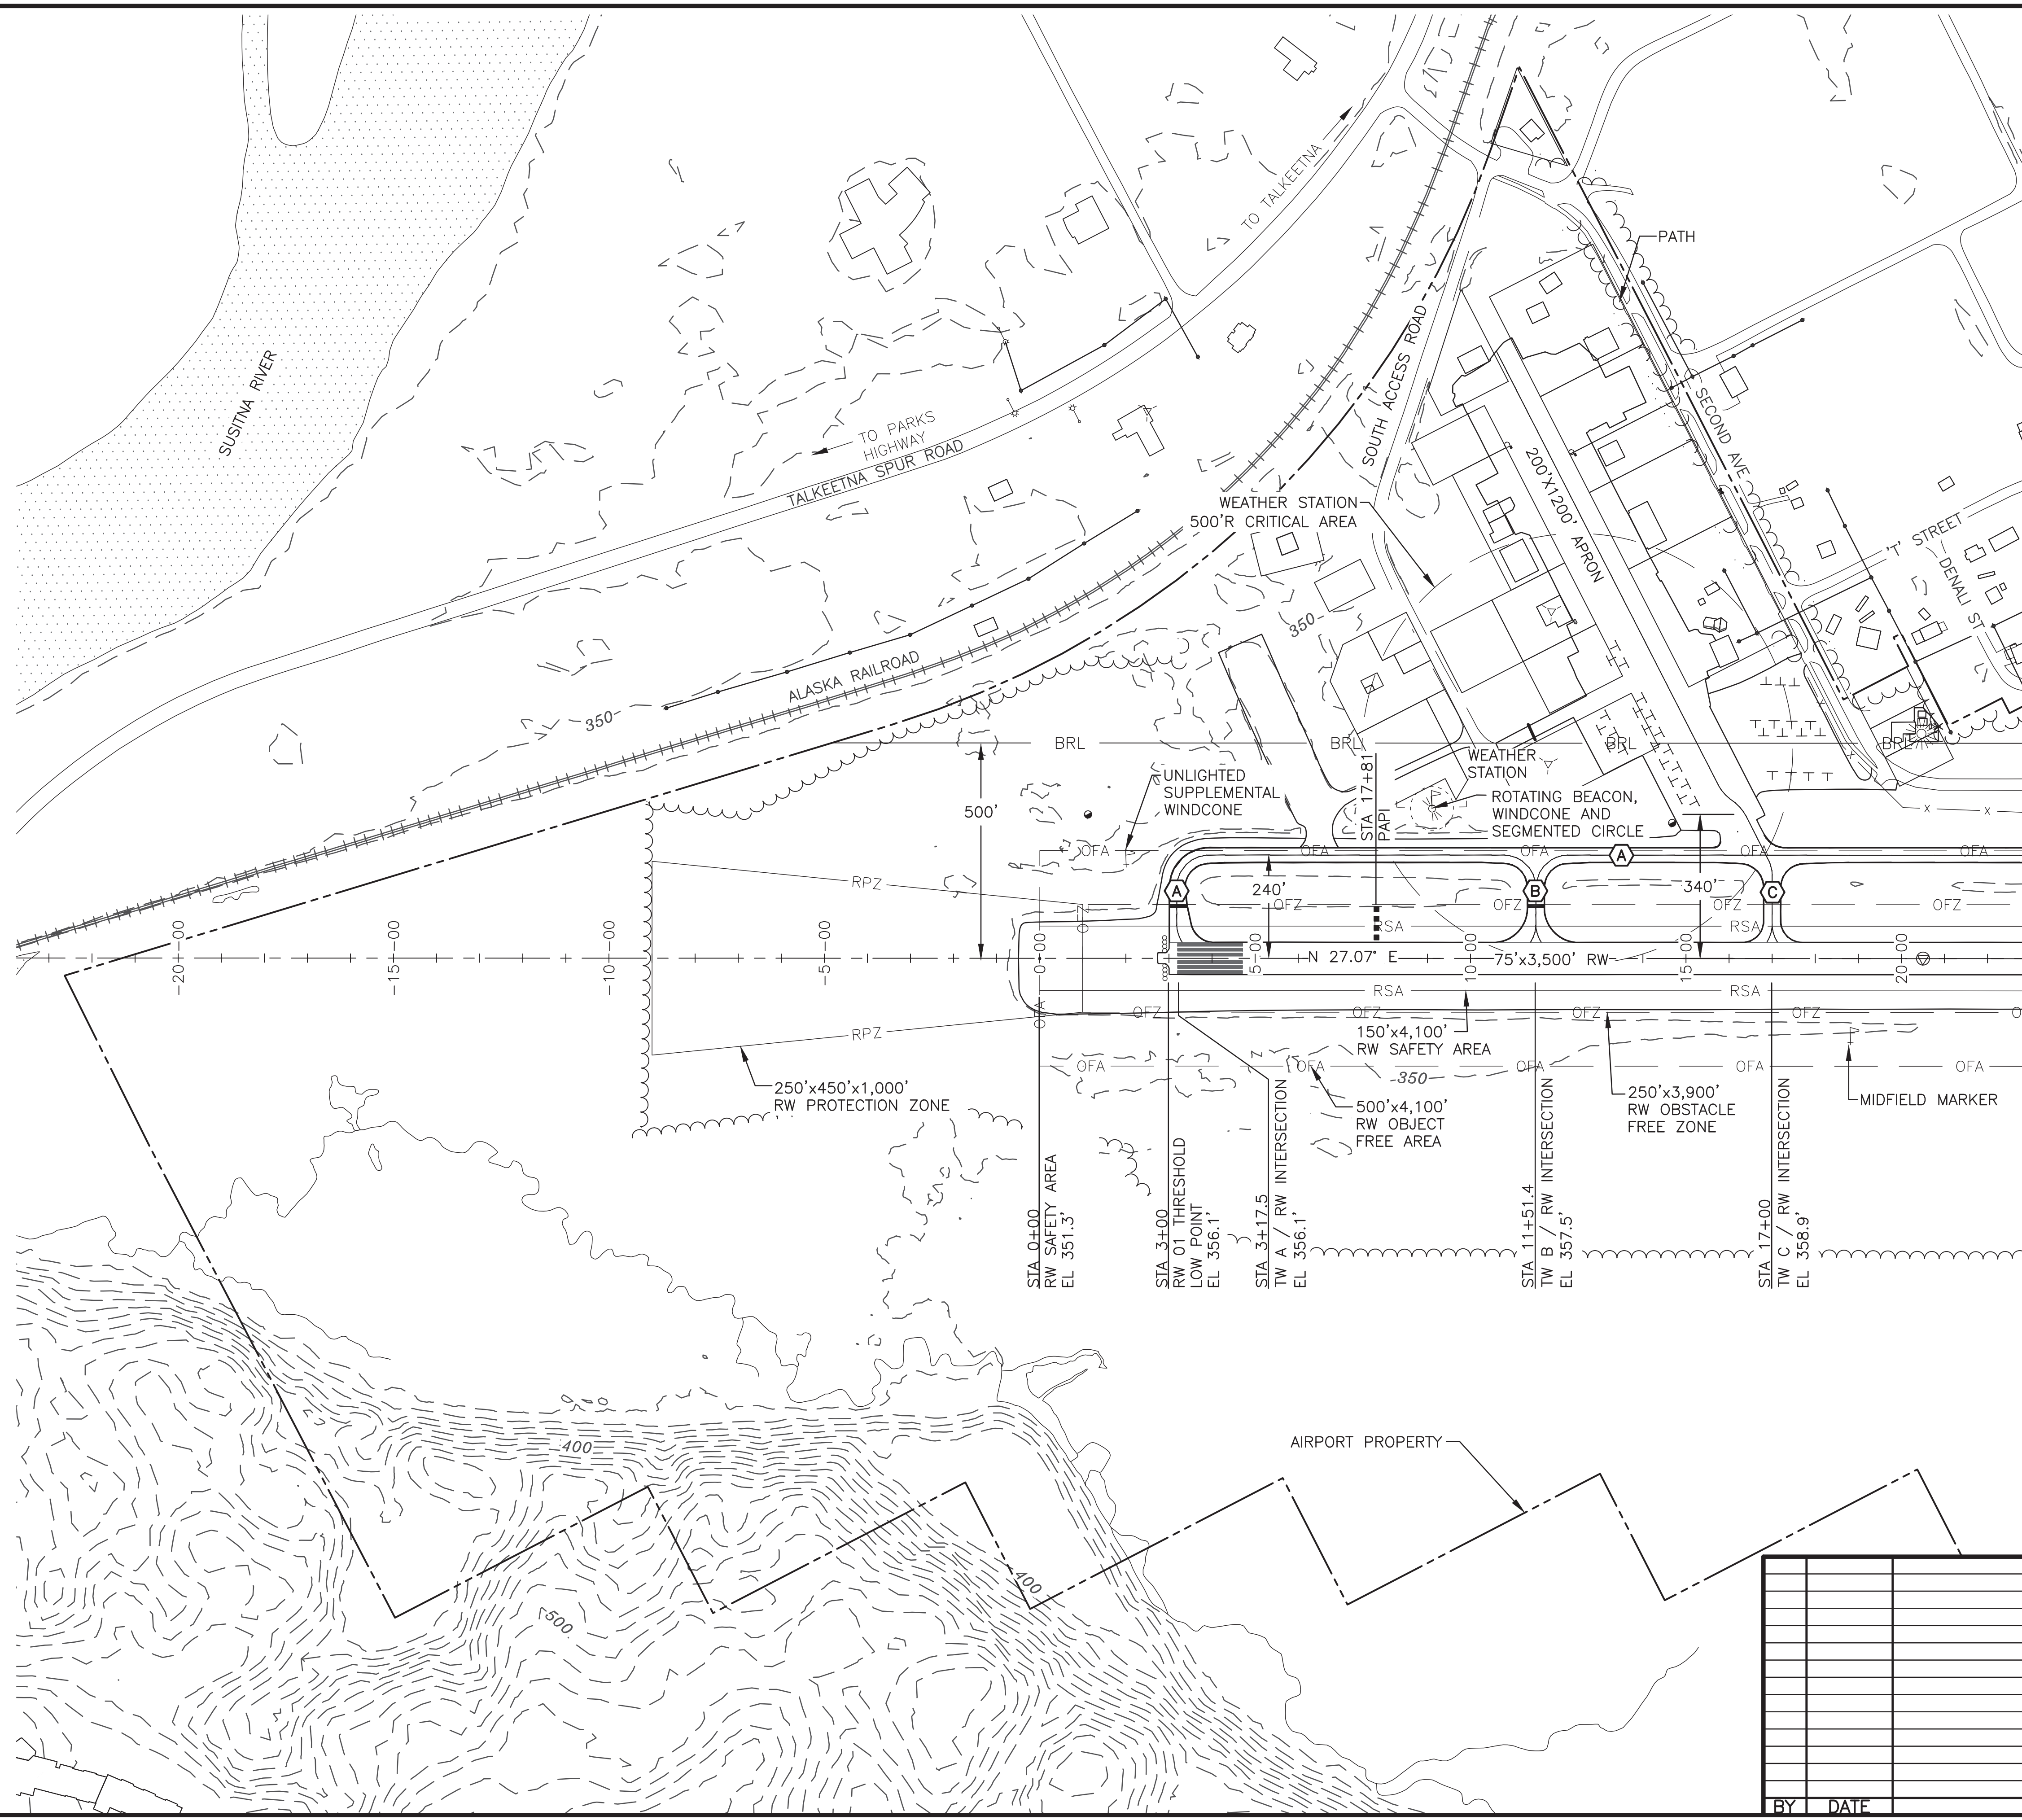

MATCH LINE RW 1-19 STA 23+00
 SEE SHEET 6

TAXIWAY DATA TABLE				
ITEM	ULTIMATE			
	WIDTH	LENGTH	TSA	TOFA
TW A	35'	3,900'	79'	131'
TW B	35'	202'	79'	131'
TW C	35'	202'	79'	131'

- NOTES:**
- NO THRESHOLD SITING SURFACE OBJECT PENETRATIONS.
 - NO OFZ PENETRATIONS.

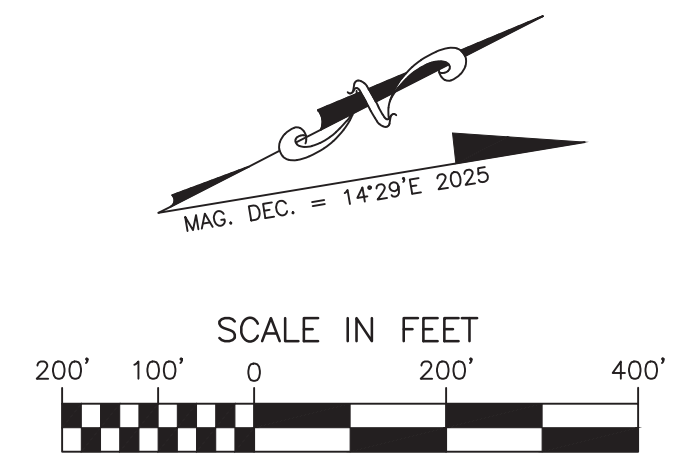

BY	DATE	REVISION

STATE OF ALASKA
DEPARTMENT OF TRANSPORTATION
AND PUBLIC FACILITIES
CENTRAL REGION

TALKEETNA AIRPORT
 TALKEETNA, ALASKA
 AIRPORT LAYOUT PLAN

ULTIMATE LAYOUT (1 OF 2)


DATE: 5/19/2020	SHEET: 5 OF 20
-----------------	----------------

Designed By: LEN
 Drawn By: ABC
 Checked By: MMS

Date Plotted: 5/19/2020, 1:03 PM
 Layout Name: 6 ULTIMATE_LAYOUT
 File Name: U:\2019\2020\TALKEETNA\Drawings\CDAs\B\11-ALP_2019\Sheet3\ALP-TA4-3-6-EX-N-ILL-LAYOUTS.dwg

ITEM	ULTIMATE			
	WIDTH	LENGTH	TSA	TOFA
TW A	35'	3,900'	79'	131'
TW D	35'	202'	79'	131'
TW E	35'	202'	79'	131'
TW F	35'	100'	79'	131'
TW G	35'	100'	79'	131'
TW H	35'	250'	79'	131'
TW J	35'	250'	79'	131'

- NOTES:**
- NO THRESHOLD SITING SURFACE OBJECT PENETRATIONS.
 - NO OFZ PENETRATIONS.

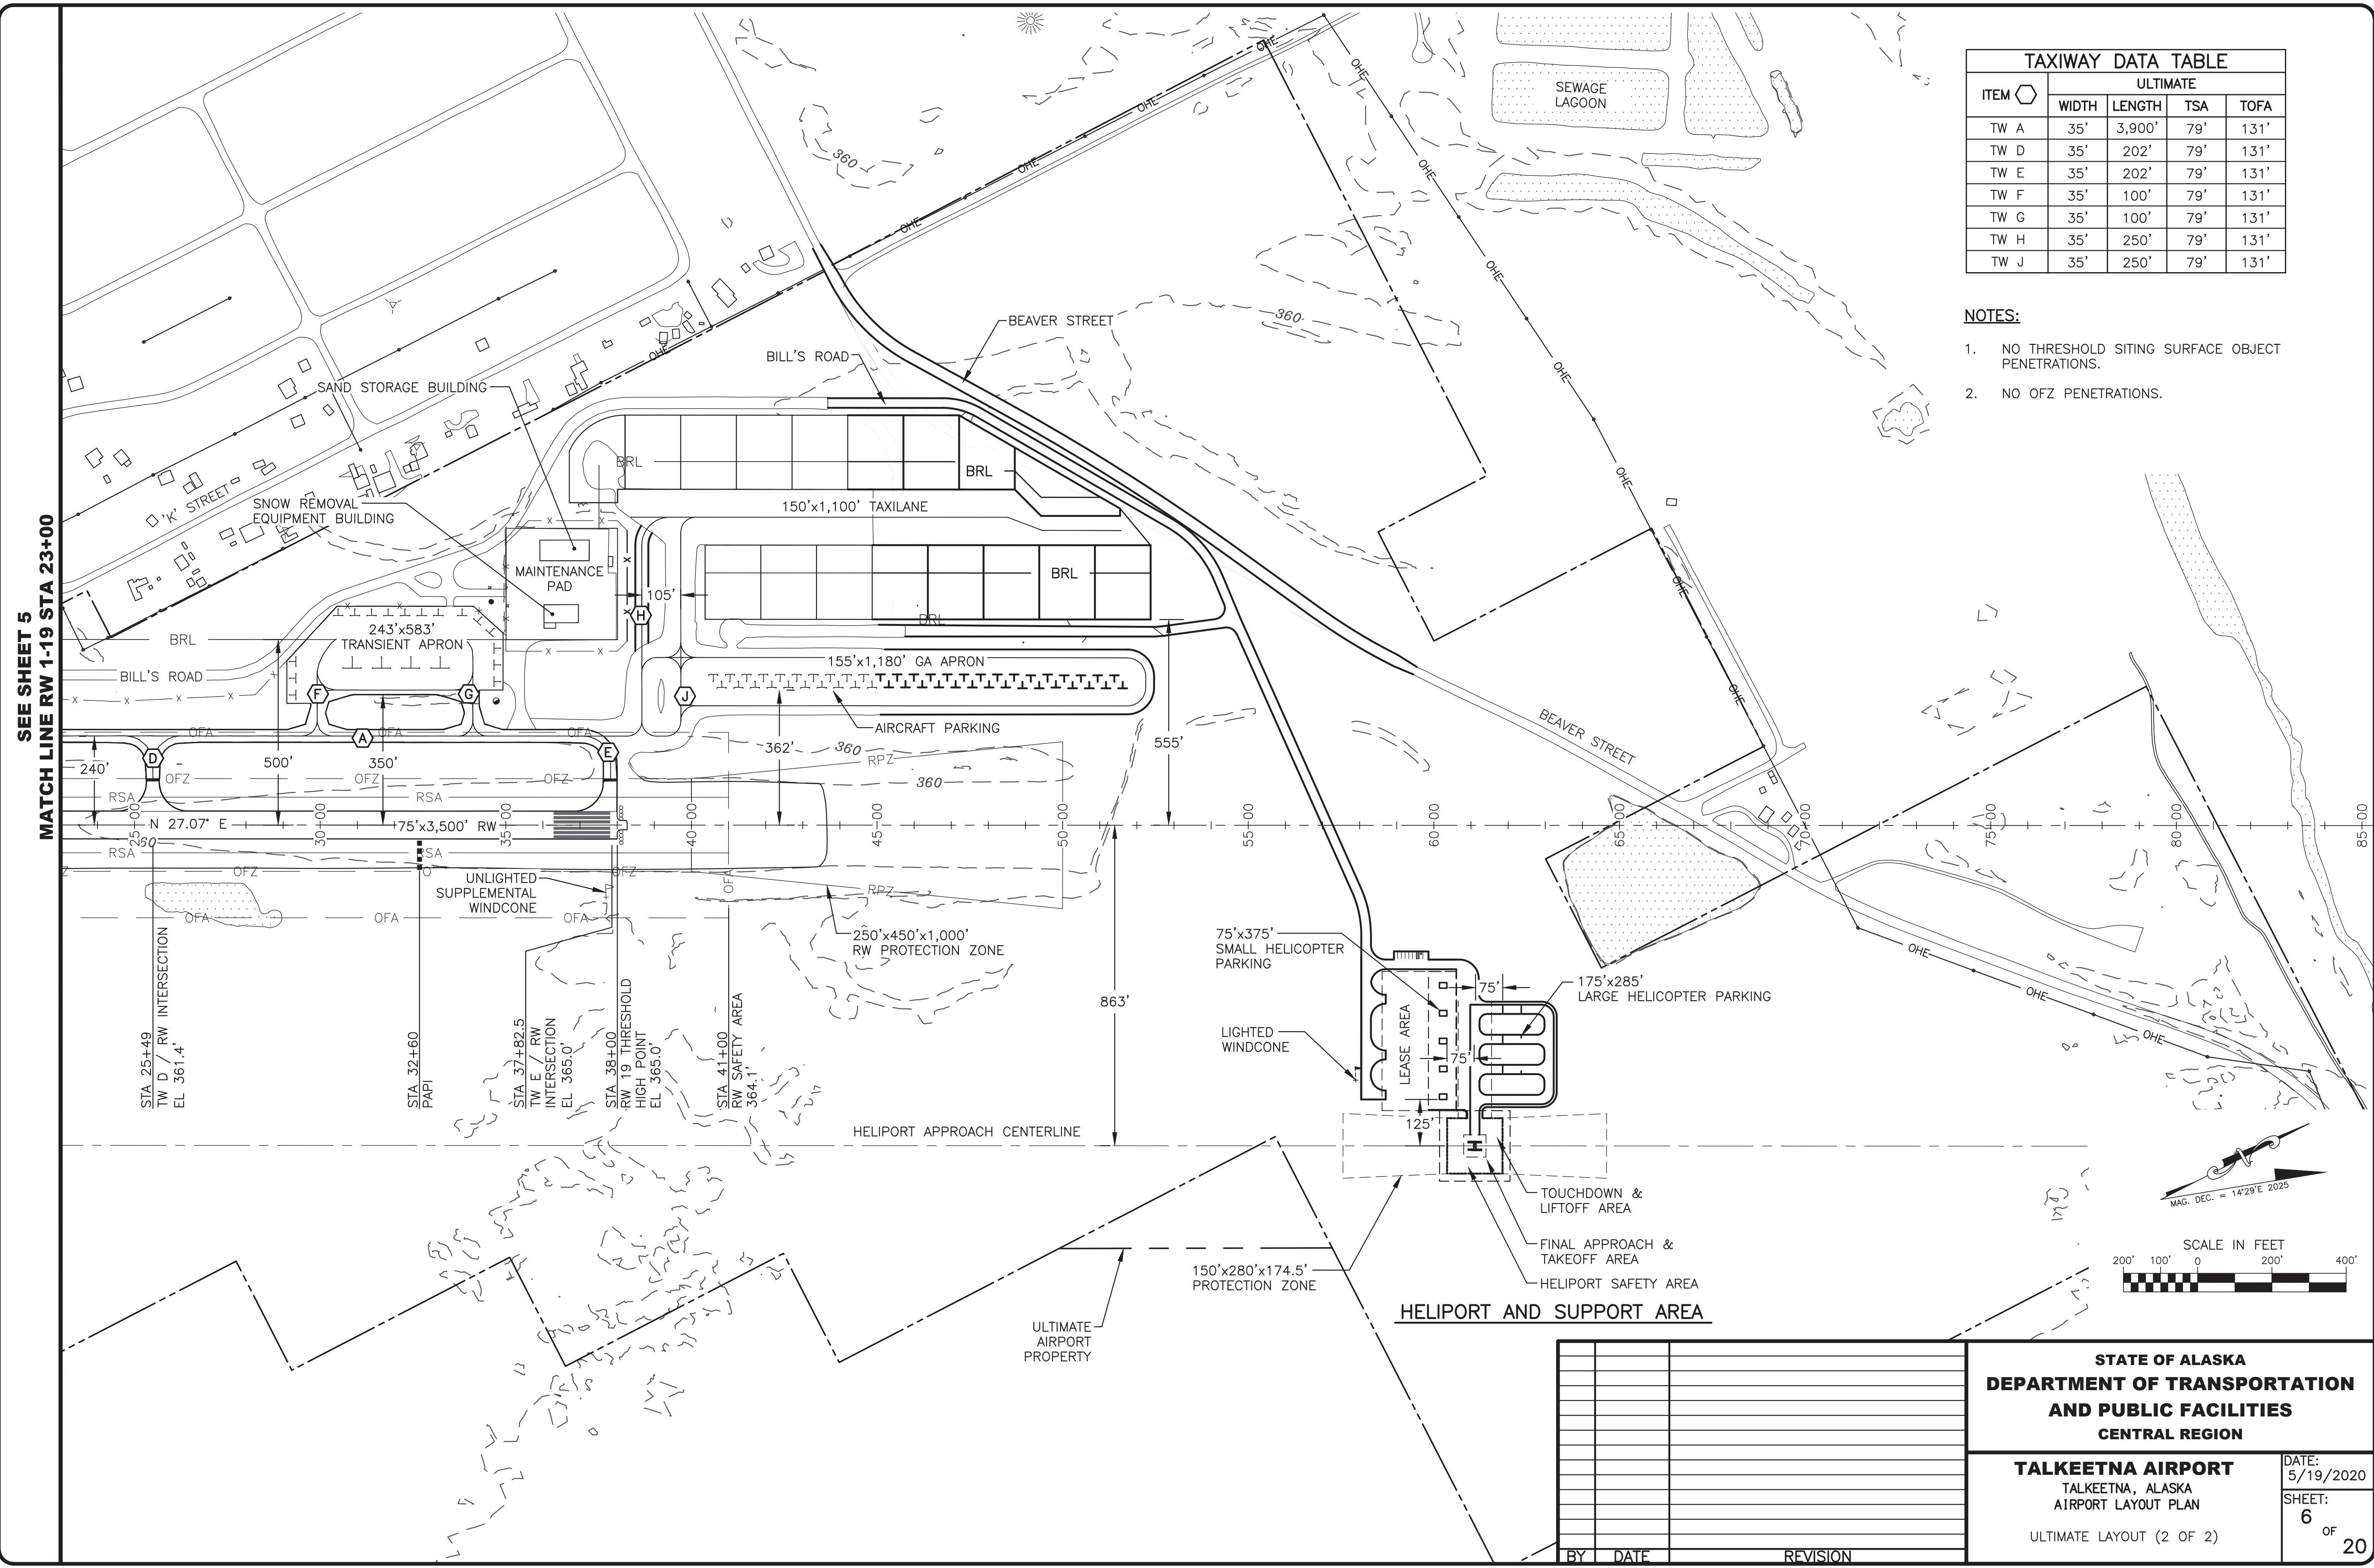

SEE SHEET 5
 MATCH LINE RW 1-19 STA 23+00

BY	DATE	REVISION


STATE OF ALASKA
DEPARTMENT OF TRANSPORTATION
AND PUBLIC FACILITIES
CENTRAL REGION

TALKEETNA AIRPORT
 TALKEETNA, ALASKA
 AIRPORT LAYOUT PLAN

ULTIMATE LAYOUT (2 OF 2)

DATE: 5/19/2020
 SHEET: 6 OF 20


Designed By: LEN
 Drawn By: ADC
 Checked By: MUG

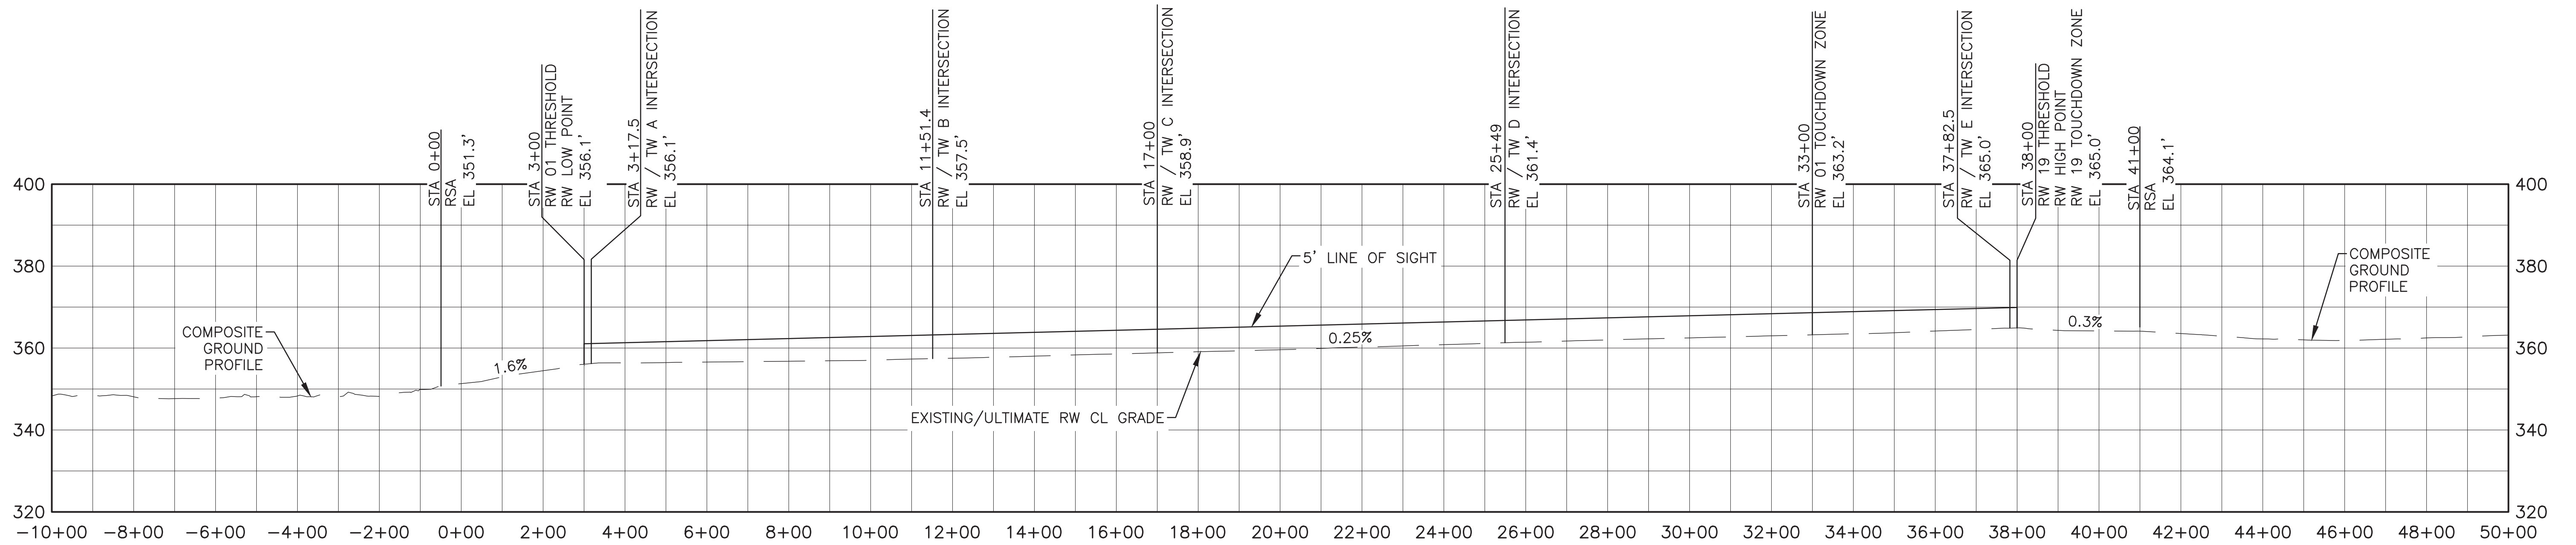

RUNWAY 01/19 PROFILE

NOTES:





- REFER TO LAYOUT SHEETS FOR EXISTING AND ULTIMATE PLAN VIEWS.
- REFER TO EXISTING/ULTIMATE INNER PORTION OF THE APPROACH SURFACES FOR OBSTRUCTION DATA AND THRESHOLD SITING CRITERIA.
- REFER TO THE AIRPORT AIRSPACE DRAWING FOR PENETRATIONS OF THE OUTER APPROACH SURFACES.
- NO OFZ PENETRATIONS.
- NO RVZ OBSTRUCTIONS.
- RUNWAYS PROVIDE CLEAR LINE OF SIGHT PER AC 150/5300-13A PARAGRAPH 305.
- THERE IS NO CHANGE TO THE EXISTING RUNWAY PROFILE IN THE ULTIMATE CONDITION.

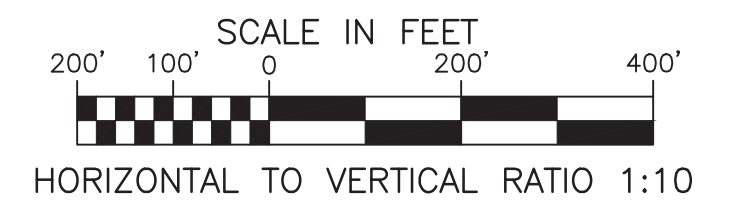

Date: 5/19/2020 1:11 PM
 Layout Name: 7 RW PROFILES
 File Name: U:\2019\2020\TALKEETNA\Drawings\CADD\11-ALP_2019\Sheets\ALP-TW-Z-F-J-PROFILES.dwg

BY	DATE	REVISION	STATE OF ALASKA DEPARTMENT OF TRANSPORTATION AND PUBLIC FACILITIES CENTRAL REGION	
			TALKEETNA AIRPORT TALKEETNA, ALASKA AIRPORT LAYOUT PLAN	
			EXISTING/ULTIMATE RUNWAY PROFILES	DATE: 5/19/2020 SHEET: 7 OF 20

DESIGNED BY: LEN
 DRAWN BY: ABC
 CHECKED BY: MMS
 DATE: 15/09/2020, 2:48 PM
 LAYOUT: 12, EXISTING INNER APPROACH SURF RW 1-19
 FILE NAME: U:\2017\02\282\Talketna\Drawings\2019\Sheets\MAP-TKA-12-14_E-APPROCH-SURF.dwg

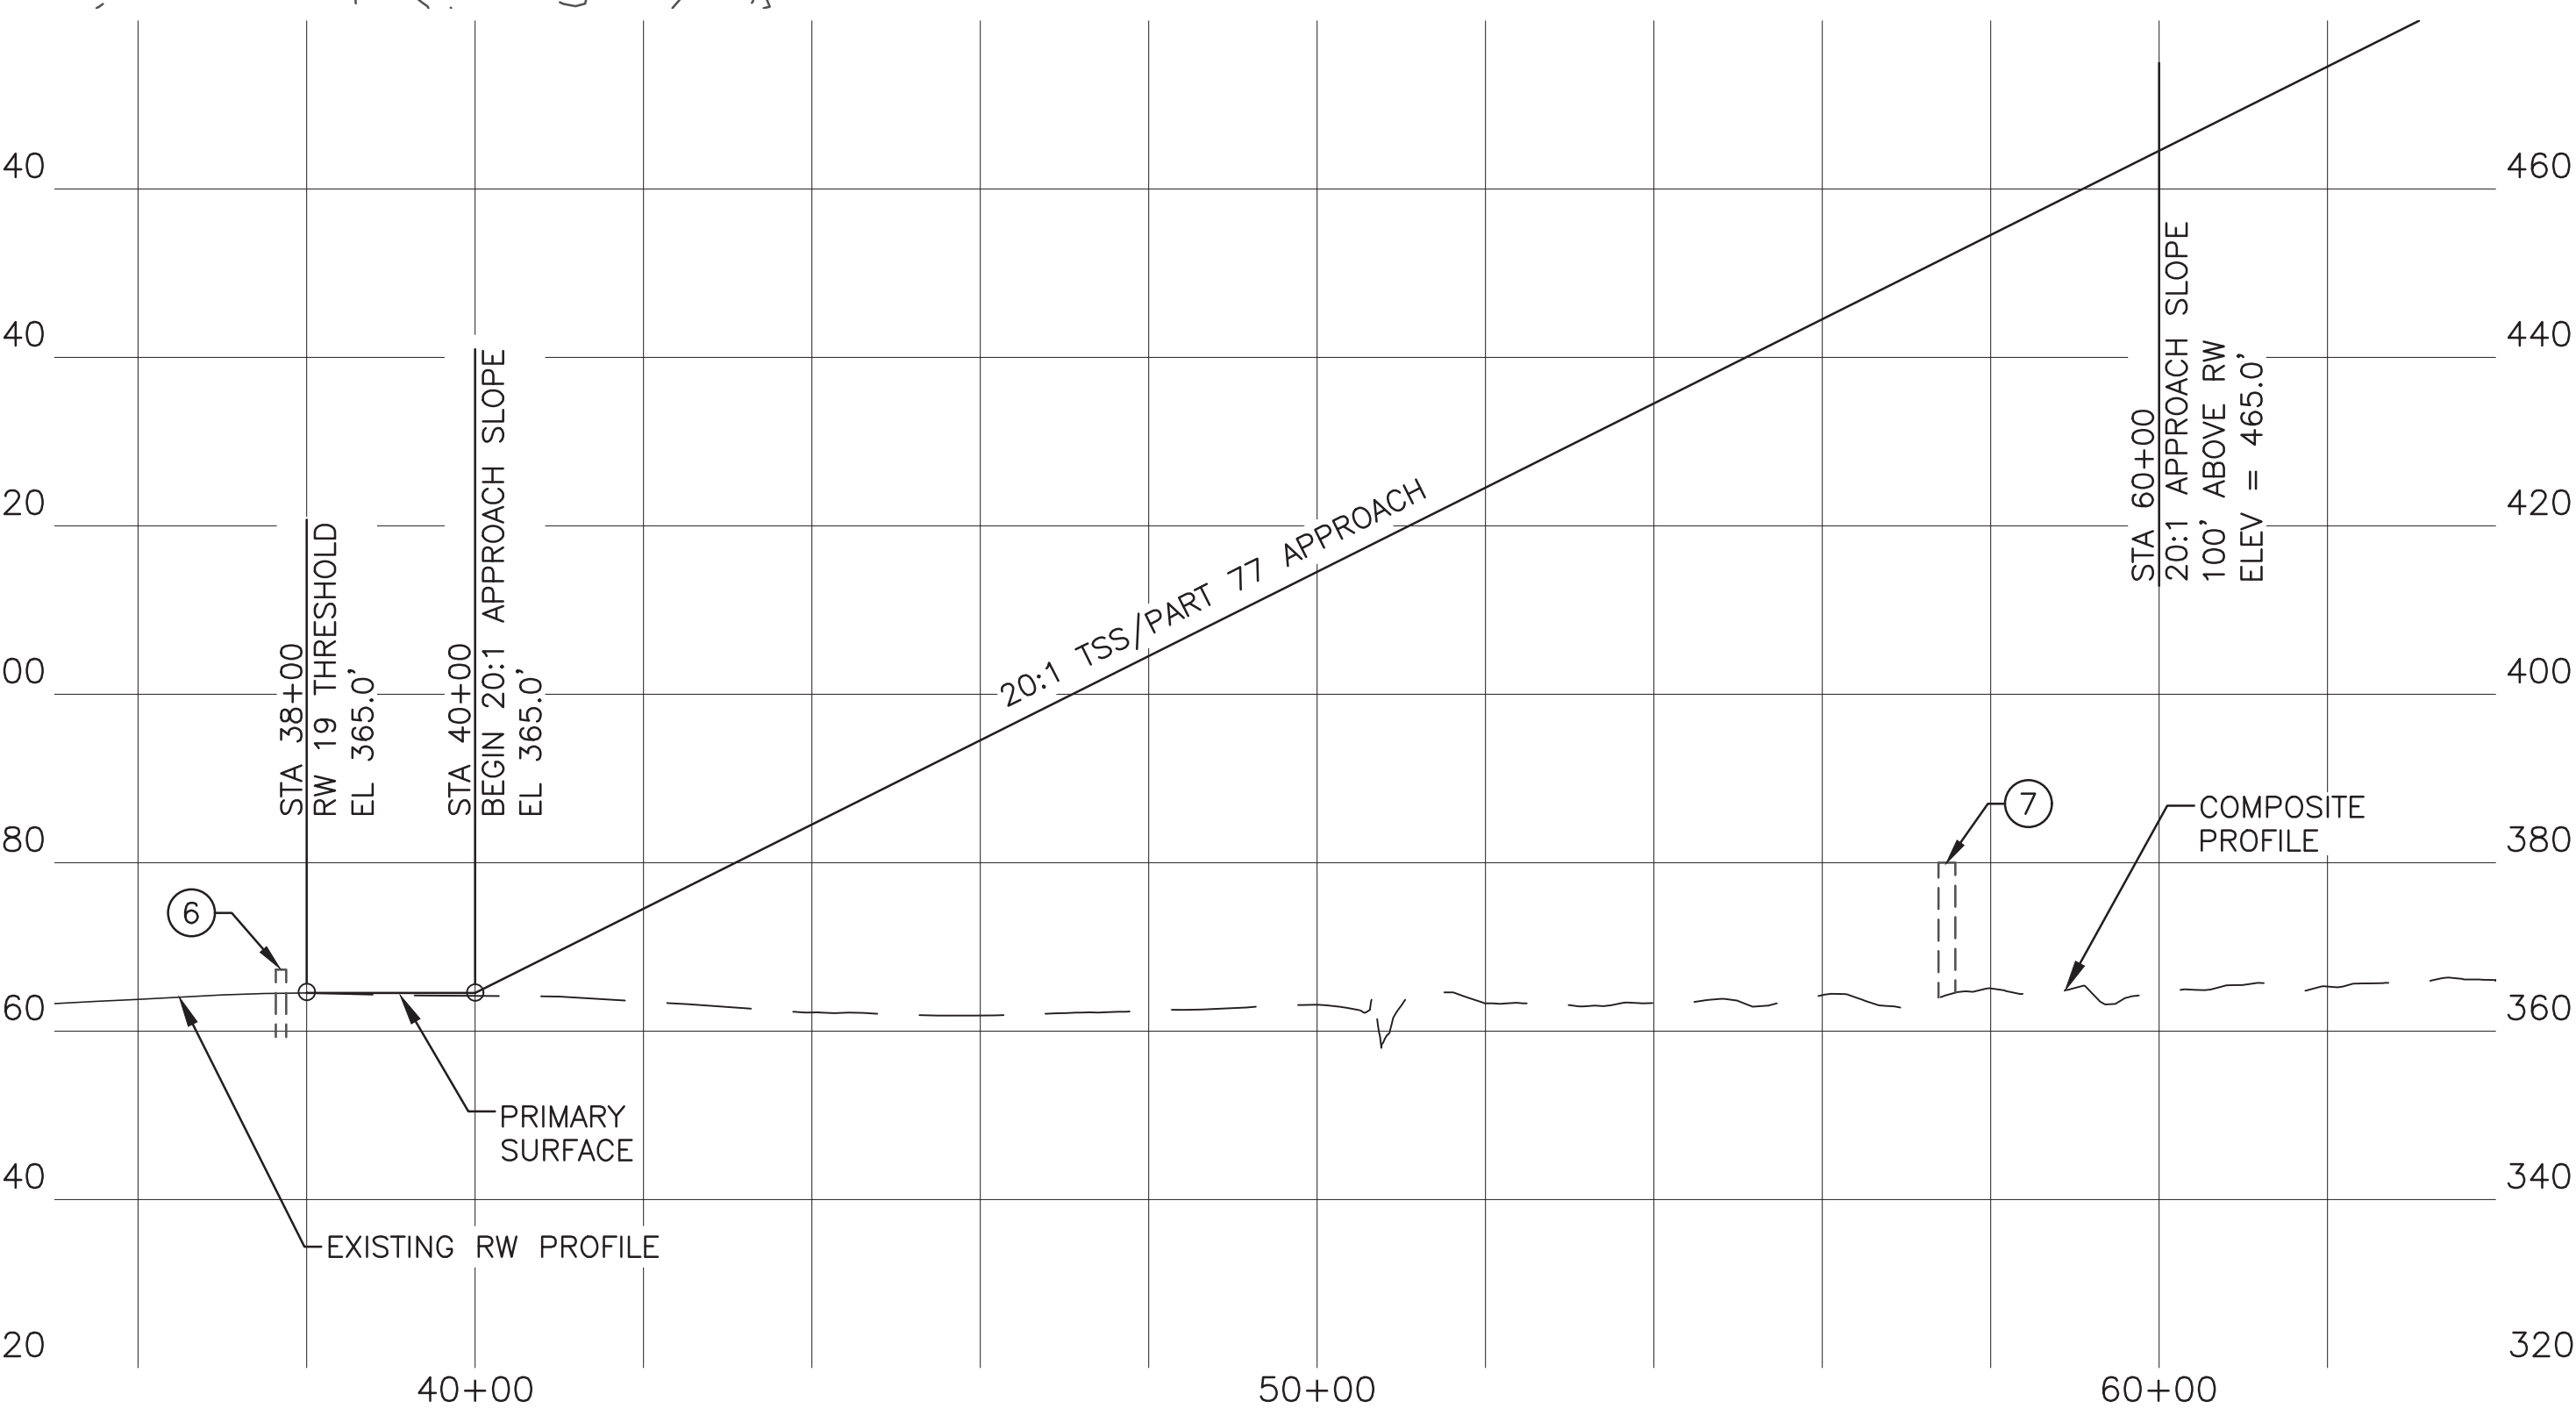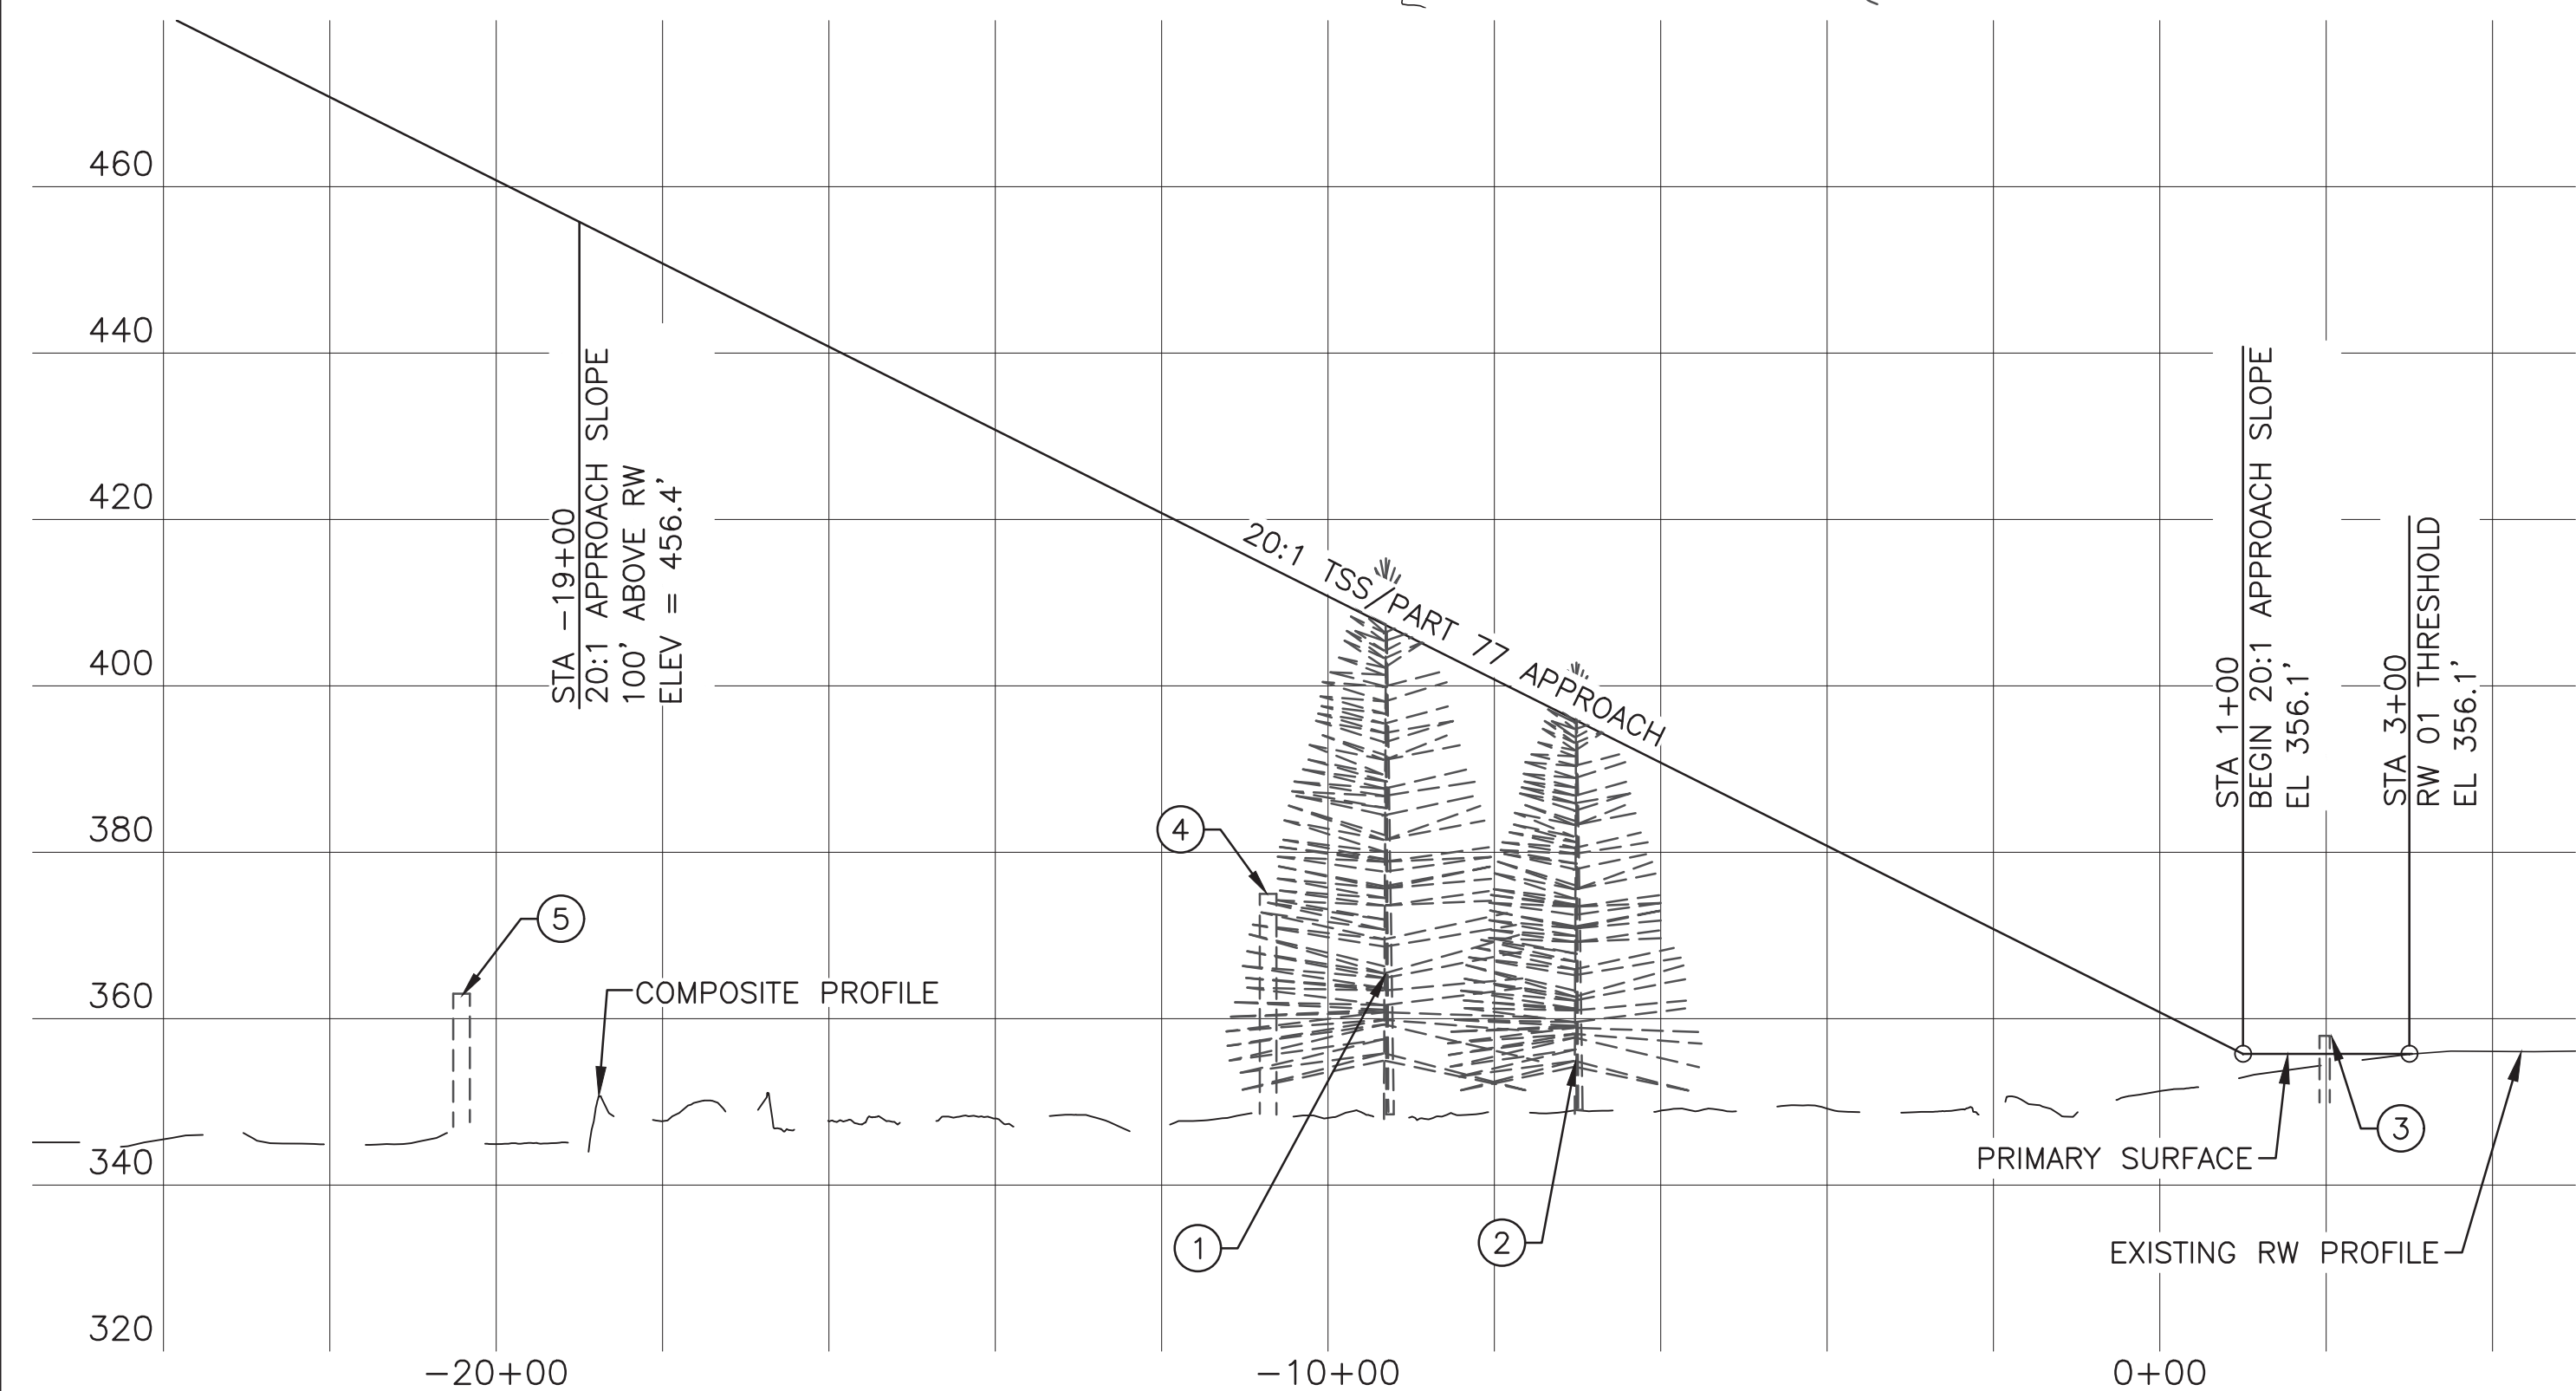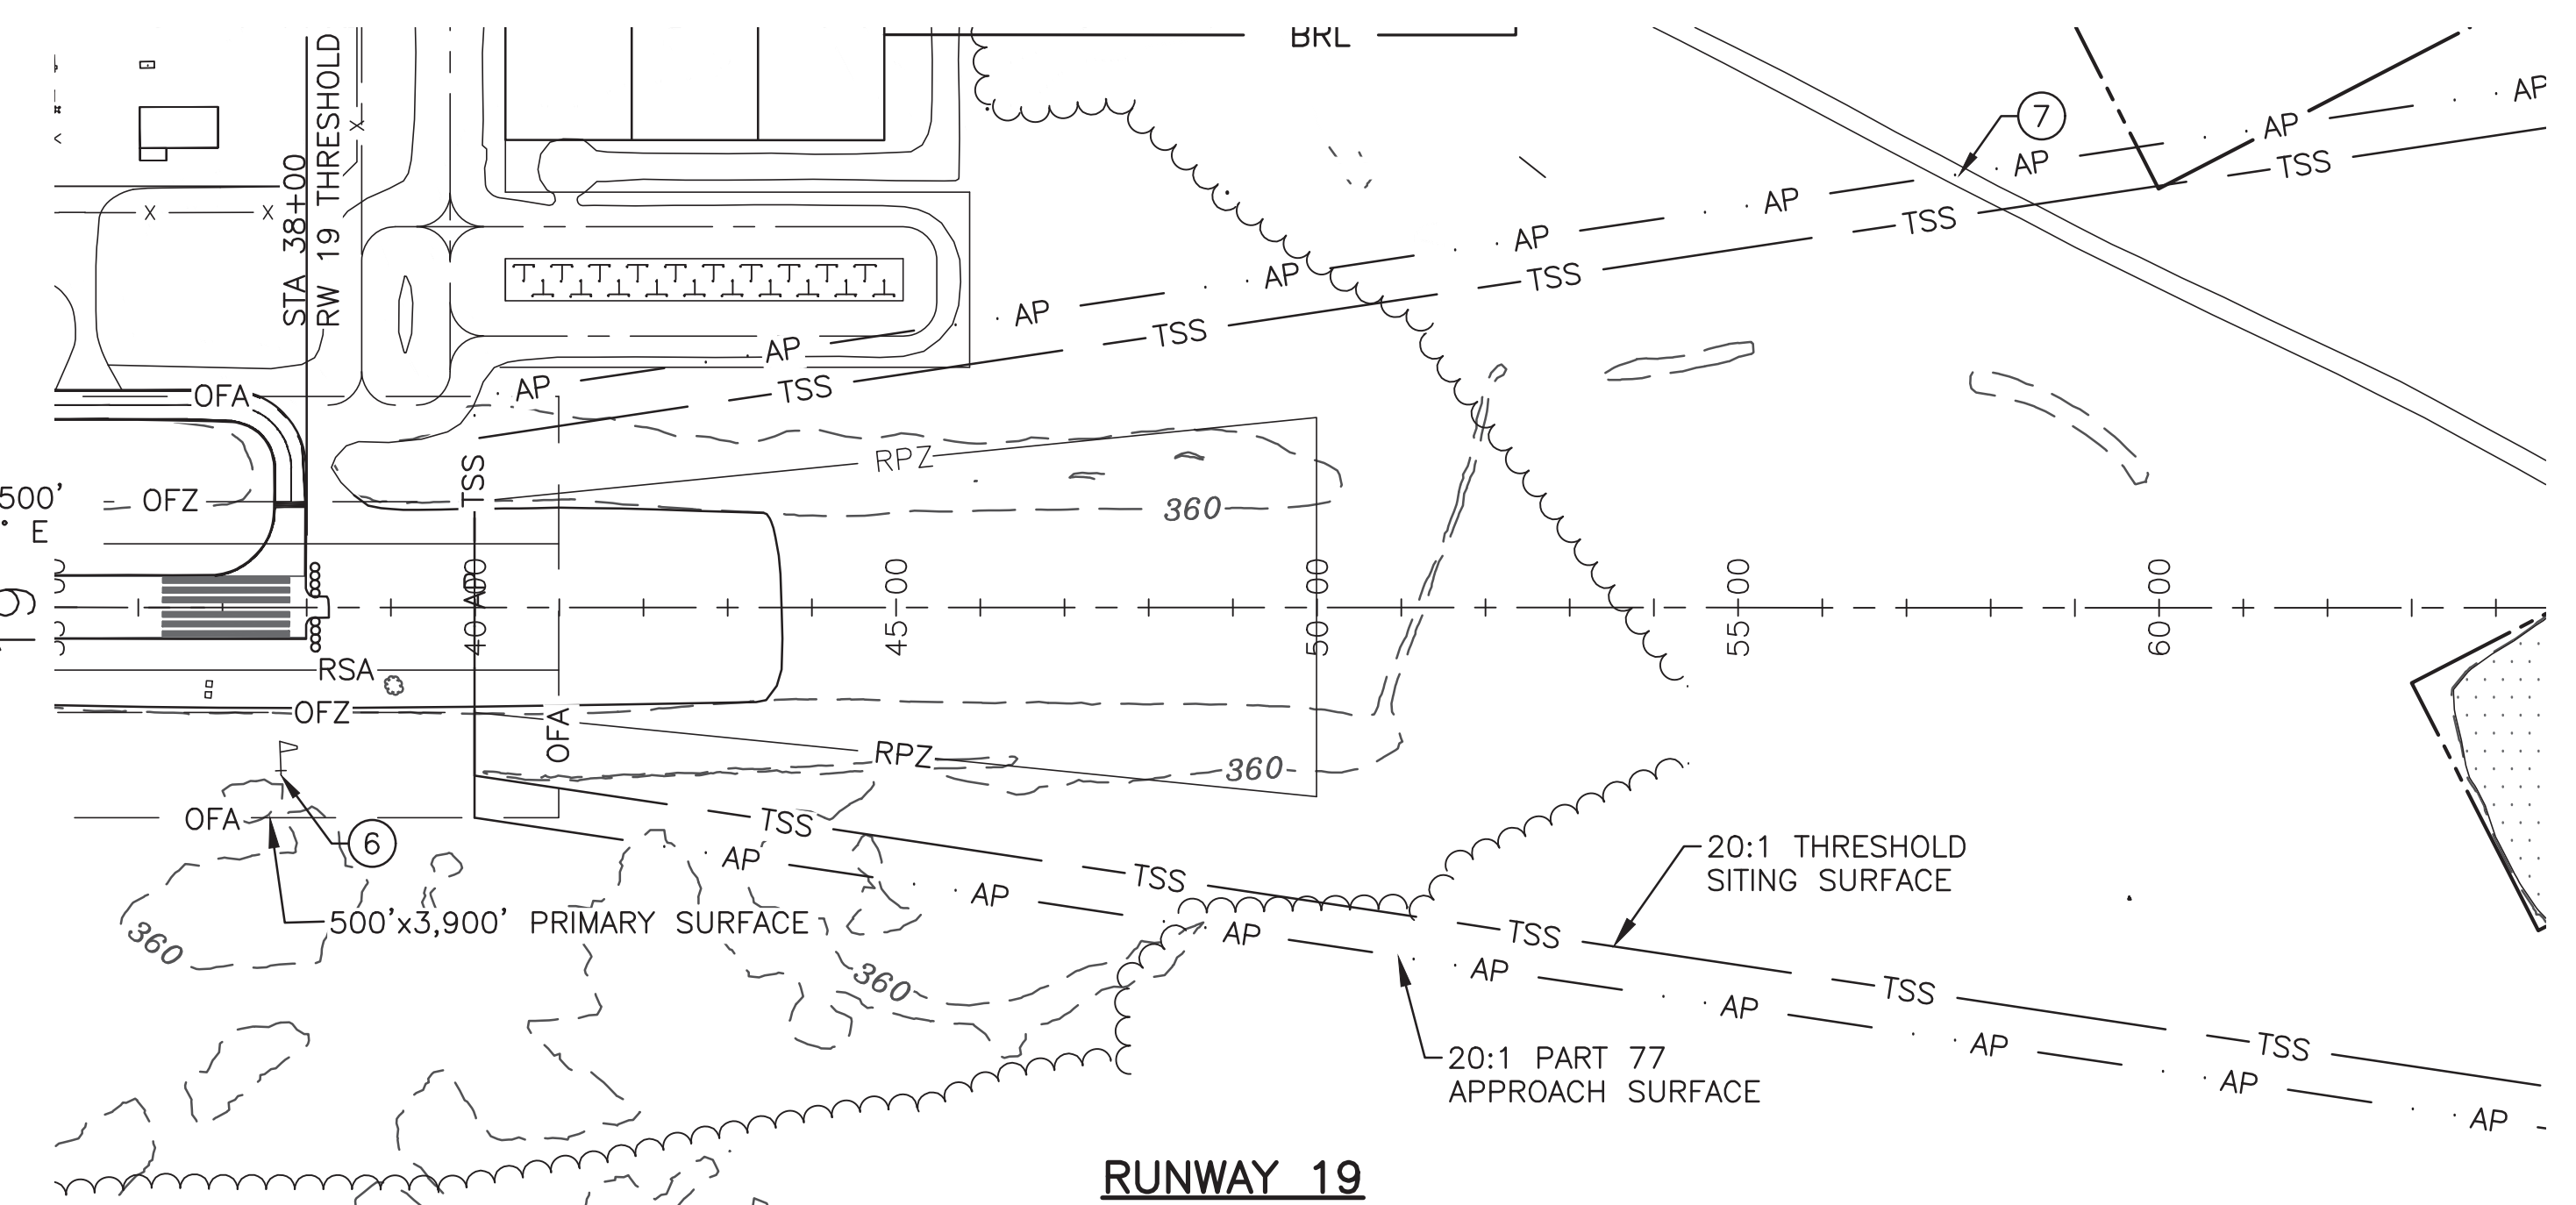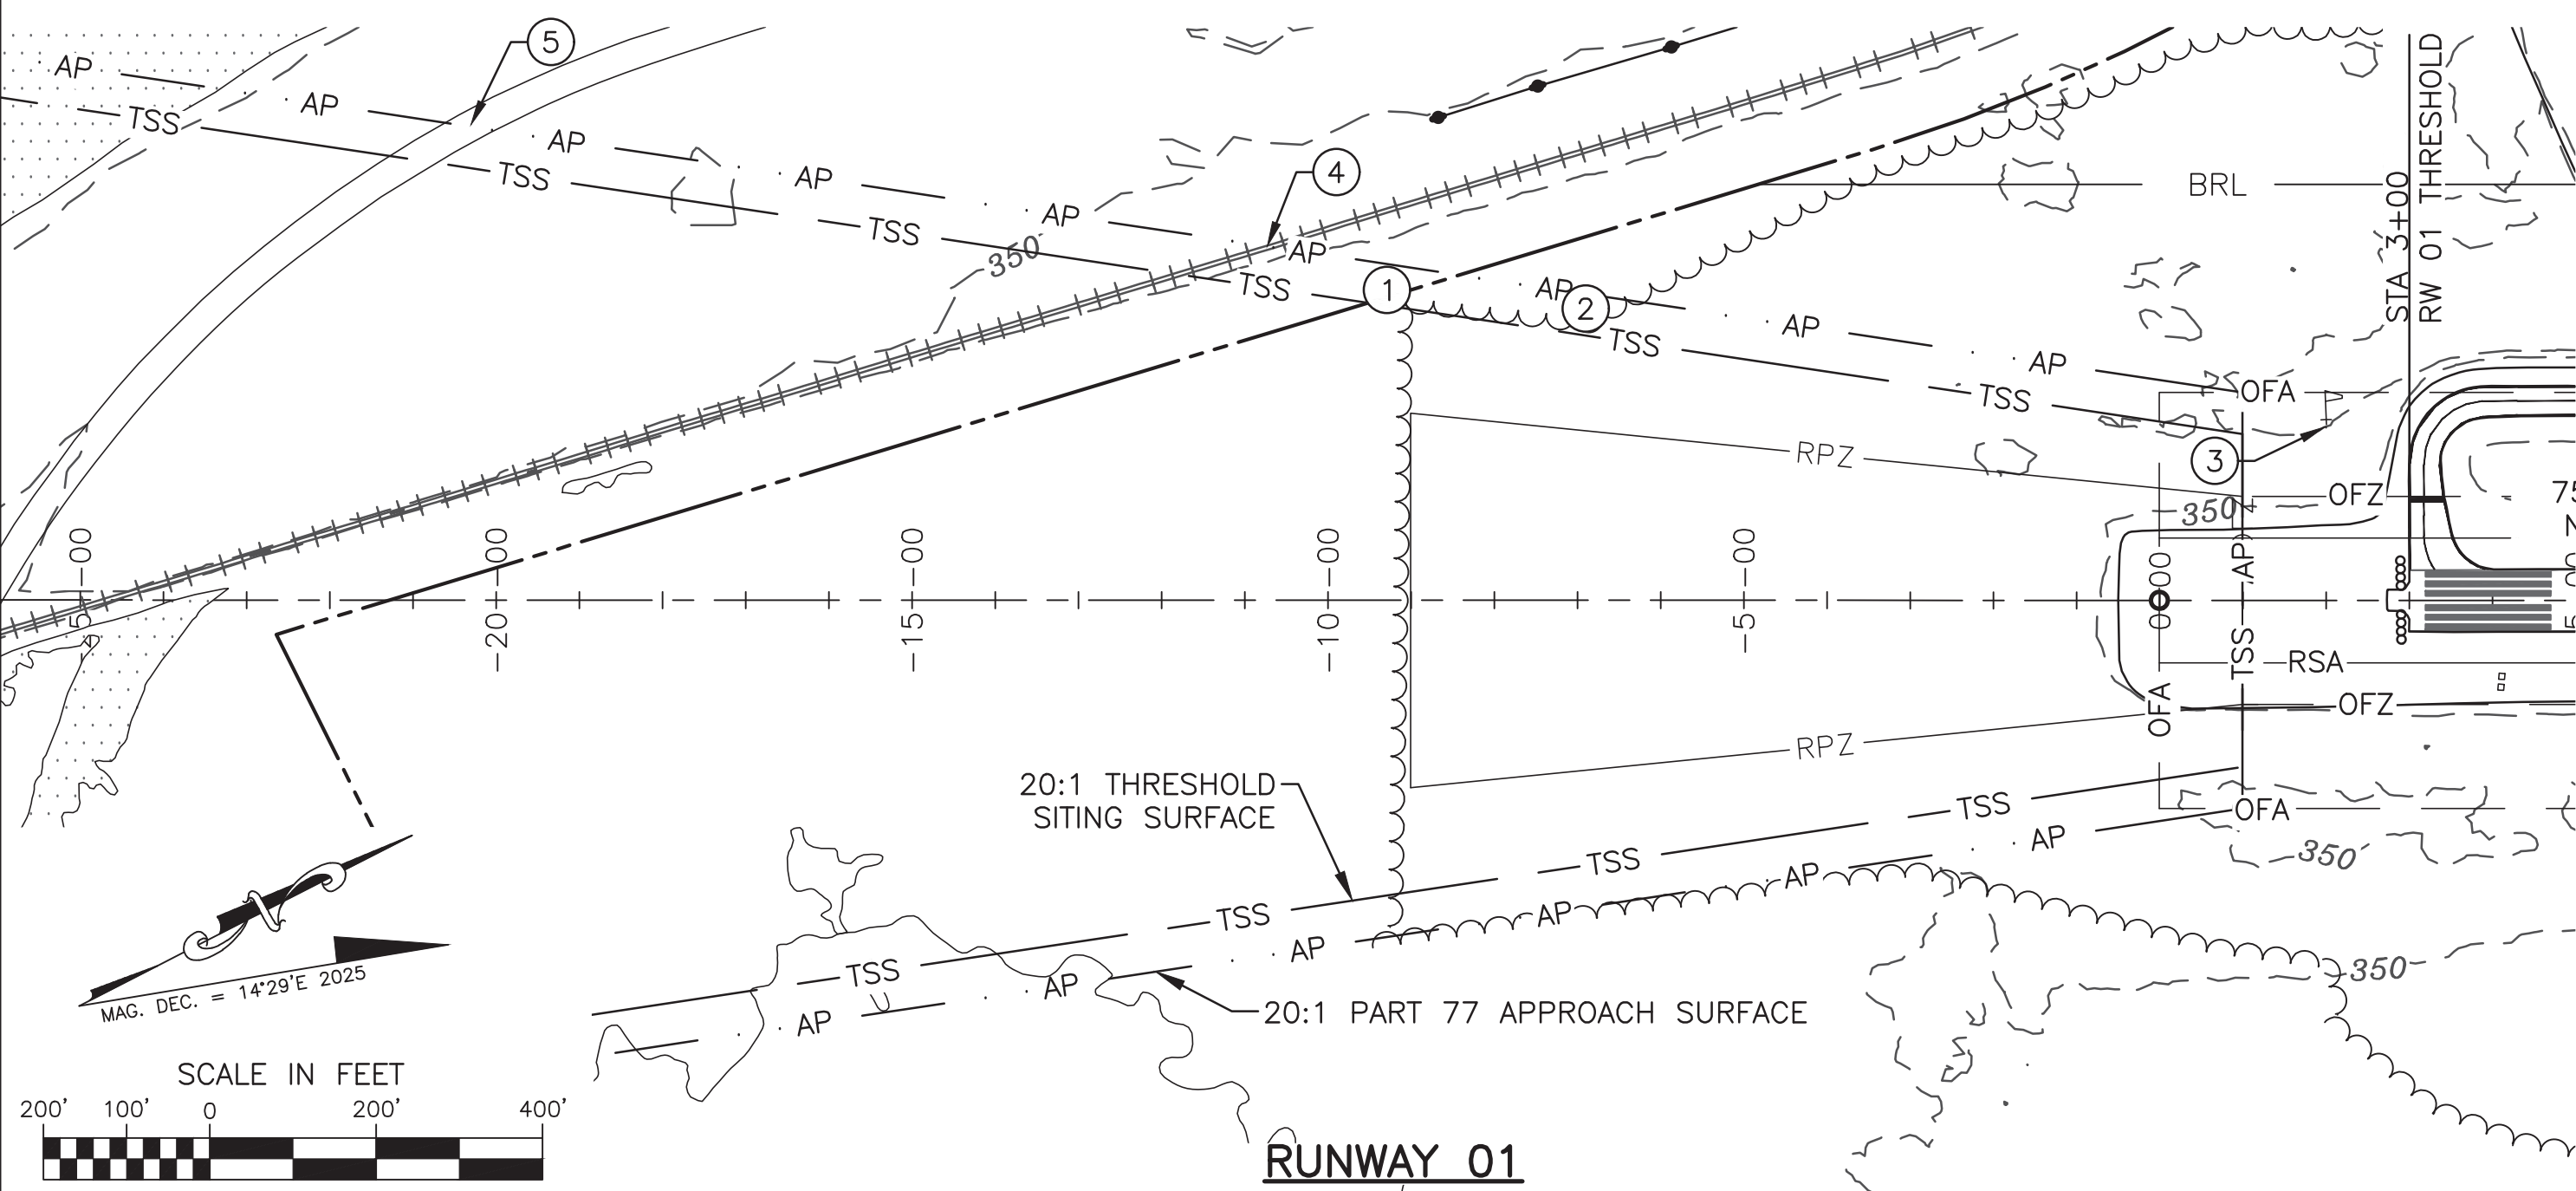

ID#	DESCRIPTION	STATION/OFFSET	BASE EL	TOP EL	SURFACE PENETRATED	SURFACE EL	AMOUNT PENETRATED	DISPOSITION	STAGE TO CORRECT
1	TREES (HP)	-9+23/374'L	349'	415'	APPROACH	408'	7'	REMOVE	ULTIMATE
2	TREES (HP)	-6+95/340'L	348'	403'	APPROACH	396'	7'	REMOVE	ULTIMATE
3	UNLIGHTED WINDCONE	2+00/210'L	350'	358'	PRIMARY	356'	2'	TO REMAIN	N/A
4	RAILROAD + 23'	-10+72/421'L	352'	375'	NONE	415'	-40'	TO REMAIN	N/A
5	ROAD + 15'	-20+43/568'L	348'	363'	NONE	472'	-109'	TO REMAIN	N/A

ID#	DESCRIPTION	STATION/OFFSET	BASE EL	TOP EL	SURFACE PENETRATED	SURFACE EL	AMOUNT PENETRATED	DISPOSITION	STAGE TO CORRECT
6	UNLIGHTED WINDCONE	37+70/202'R	359'	367'	PRIMARY	365'	2'	TO REMAIN	N/A
7	ROAD + 15'	57+48/515'L	365'	380'	NONE	454'	-74'	TO REMAIN	N/A

NOTES:

- REFER TO THE AIRPORT AIRSPACE DRAWING FOR PENETRATIONS OF THE OUTER APPROACH SURFACES.
- MAPPING SHOWN ON THIS SHEET IS THE COMBINED TOPOGRAPHIC SURVEY AND CONTROLLED AERIAL MAPPING.
- THRESHOLD SITING IS DEFINED PER ENGINEERING BRIEF #99, TABLE 3-2, RUNWAY TYPE 4.
- OBSTRUCTIONS LISTED IN THE PART 77 SURFACE OBSTRUCTION TABLE ALSO PENETRATE THRESHOLD SITING SURFACE BY THE SAME MAGNITUDE.
- THE MOVEABLE OBJECT HEIGHT IS 15' FOR ROADS AND 23' FOR RAILROADS.


- NOTES:**
- REFER TO THE AIRPORT AIRSPACE DRAWING FOR PENETRATIONS OF THE OUTER APPROACH SURFACES.
 - MAPPING SHOWN ON THIS SHEET IS THE COMBINED TOPOGRAPHIC SURVEY AND CONTROLLED AERIAL MAPPING.
 - THRESHOLD SITING IS DEFINED PER ENGINEERING BRIEF #99, TABLE 3-2, RUNWAY TYPE 4.
 - OBSTRUCTIONS LISTED IN THE PART 77 SURFACE OBSTRUCTION TABLE ALSO PENETRATE THRESHOLD SITING SURFACE BY THE SAME MAGNITUDE.
 - THE CONTROLLING OBSTRUCTIONS FOR RUNWAY 1 ARE THE TREES IDENTIFIED AS OBSTRUCTIONS 1 AND 2.
 - THE MOVEABLE OBJECT HEIGHT IS 15' FOR ROADS AND 23' FOR RAILROADS.

BY	DATE	REVISION





STATE OF ALASKA
DEPARTMENT OF TRANSPORTATION
AND PUBLIC FACILITIES
CENTRAL REGION

TALKEETNA AIRPORT
 TALKEETNA, ALASKA
 AIRPORT LAYOUT PLAN
 EXISTING INNER PORTION OF
 THE APPROACH SURFACE -
 RUNWAY 1-19

DATE:
 5/20/2020
 SHEET:
 12
 OF
 20

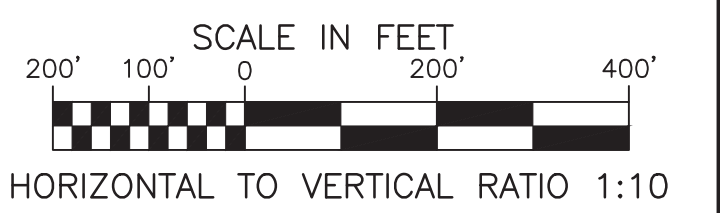

Designed By: LBN
 Drawn By: ABC
 Checked By: MMS
 Date: 15/09/2020, 2:54 PM
 Location: U:\2017\02\282\Talketna\Draws\CA\5-Built-APP-2019\Sheets\MAP-TKA-12-14_E-APPROCH-SURF.dwg
 File Name: U:\2017\02\282\Talketna\Draws\CA\5-Built-APP-2019\Sheets\MAP-TKA-12-14_E-APPROCH-SURF.dwg

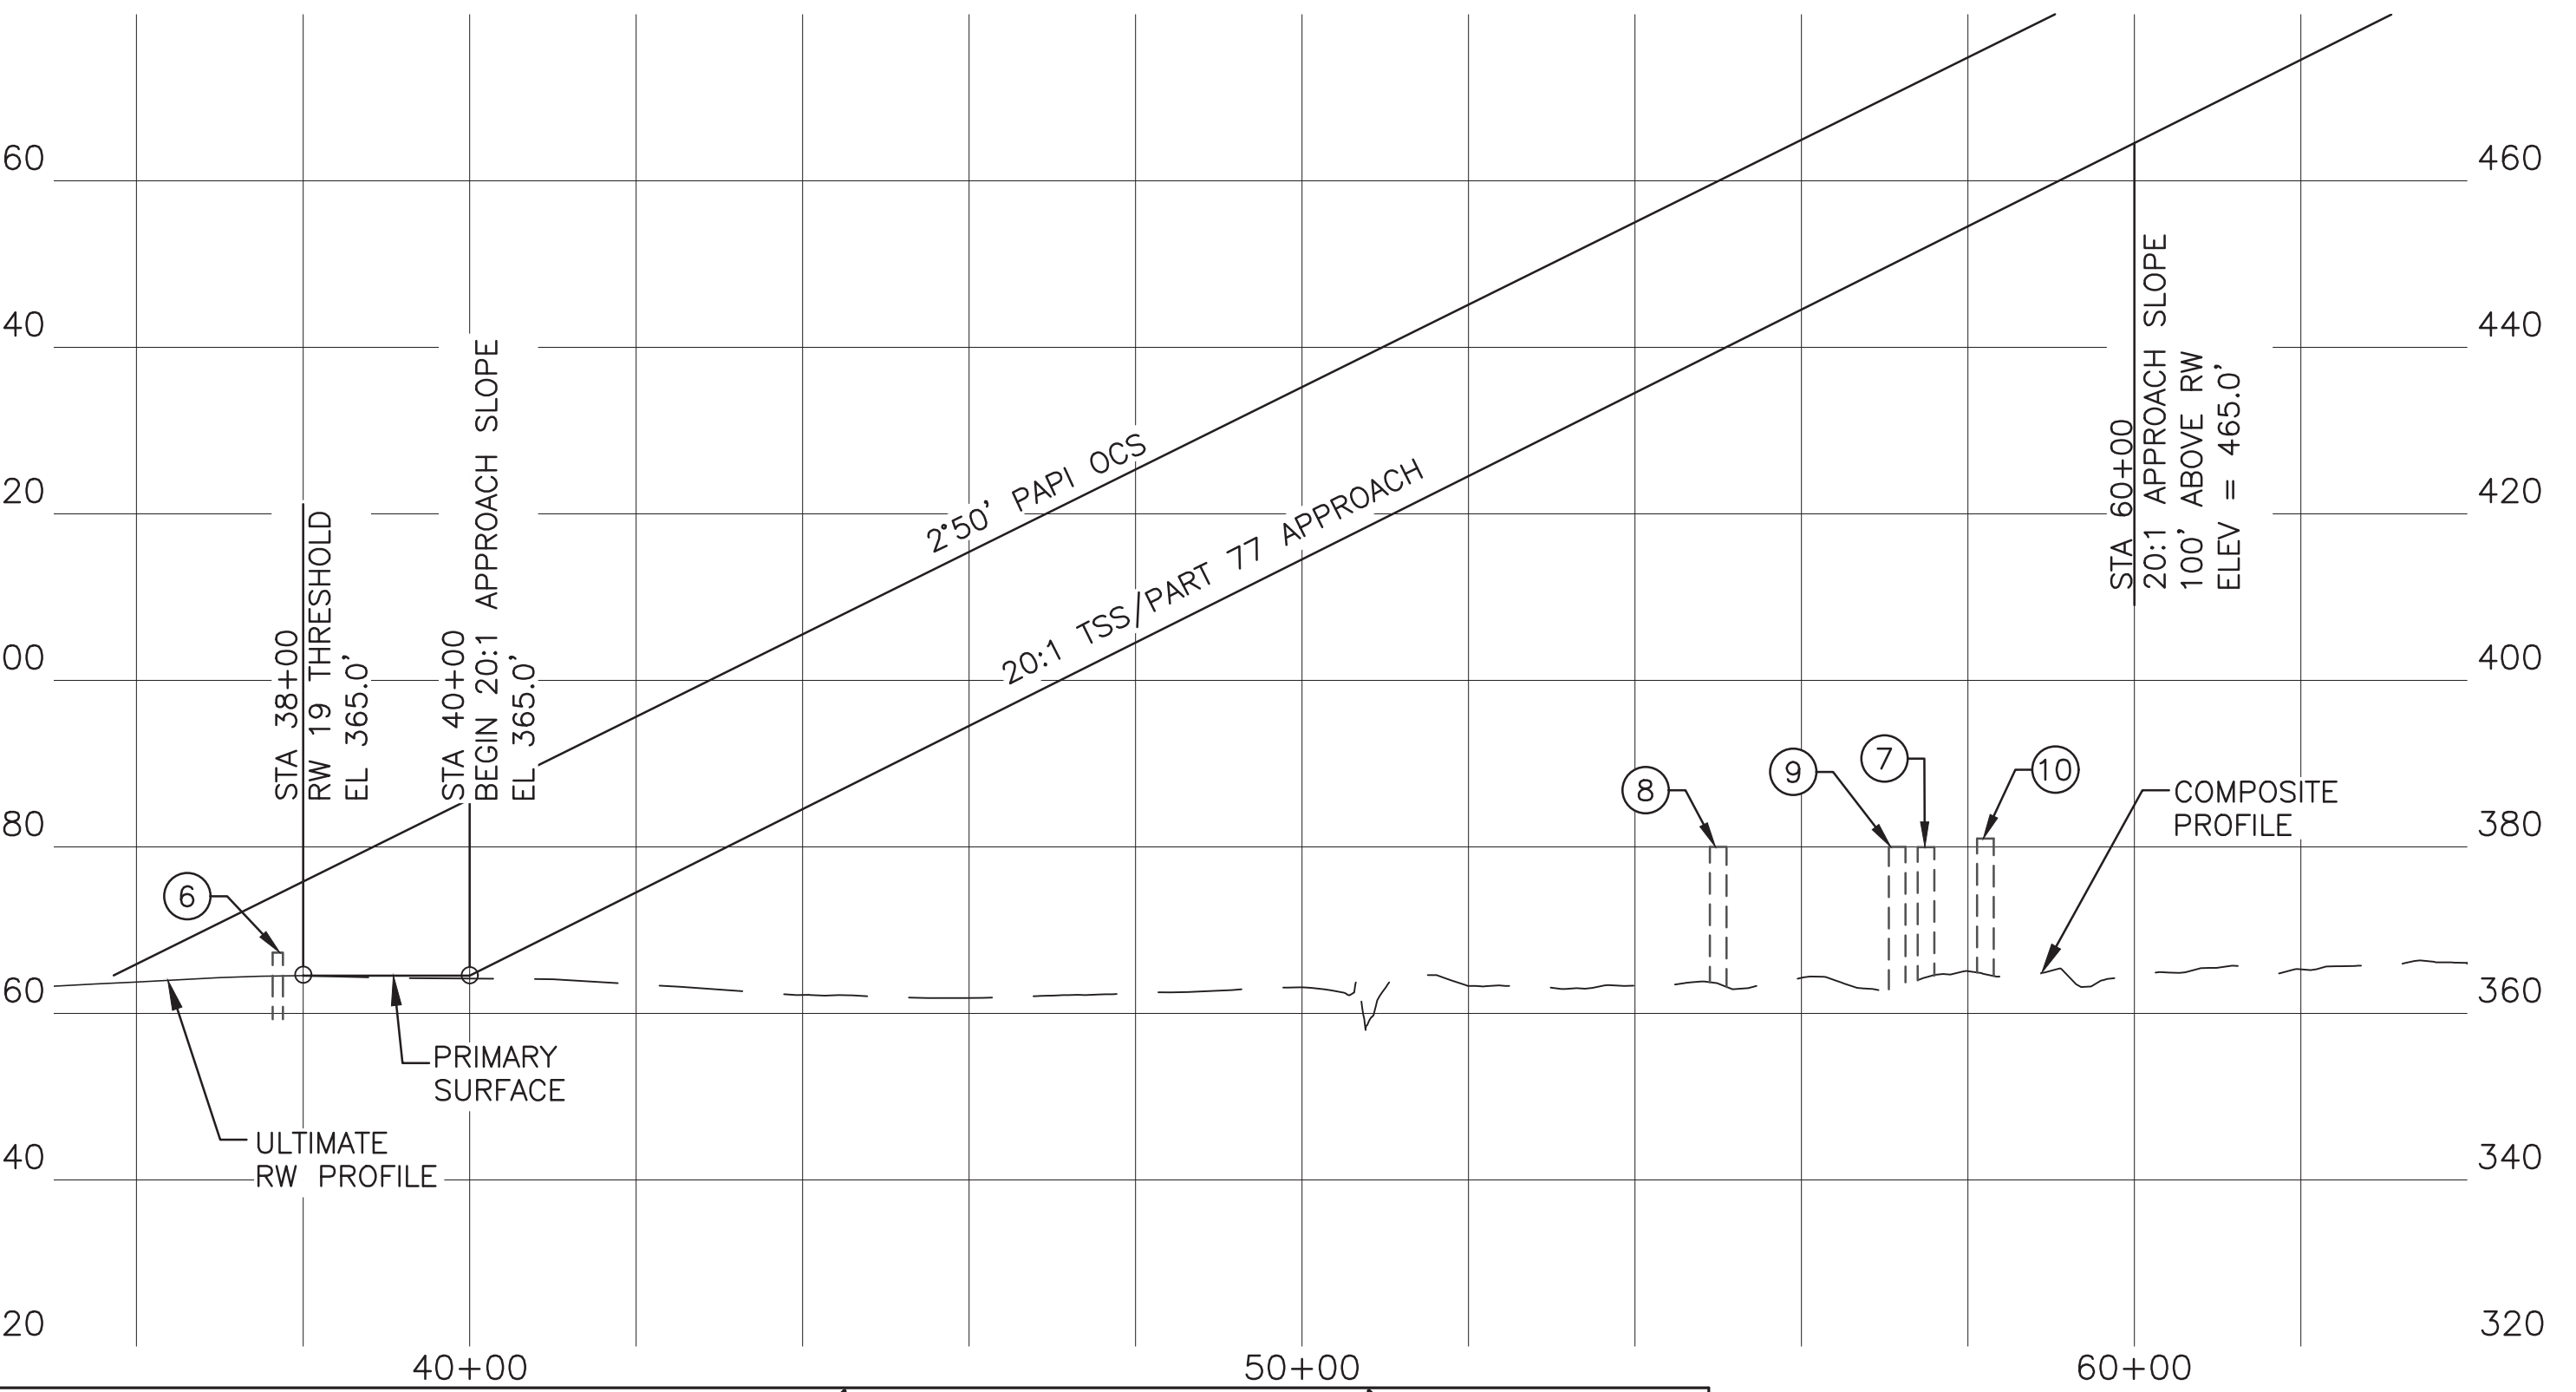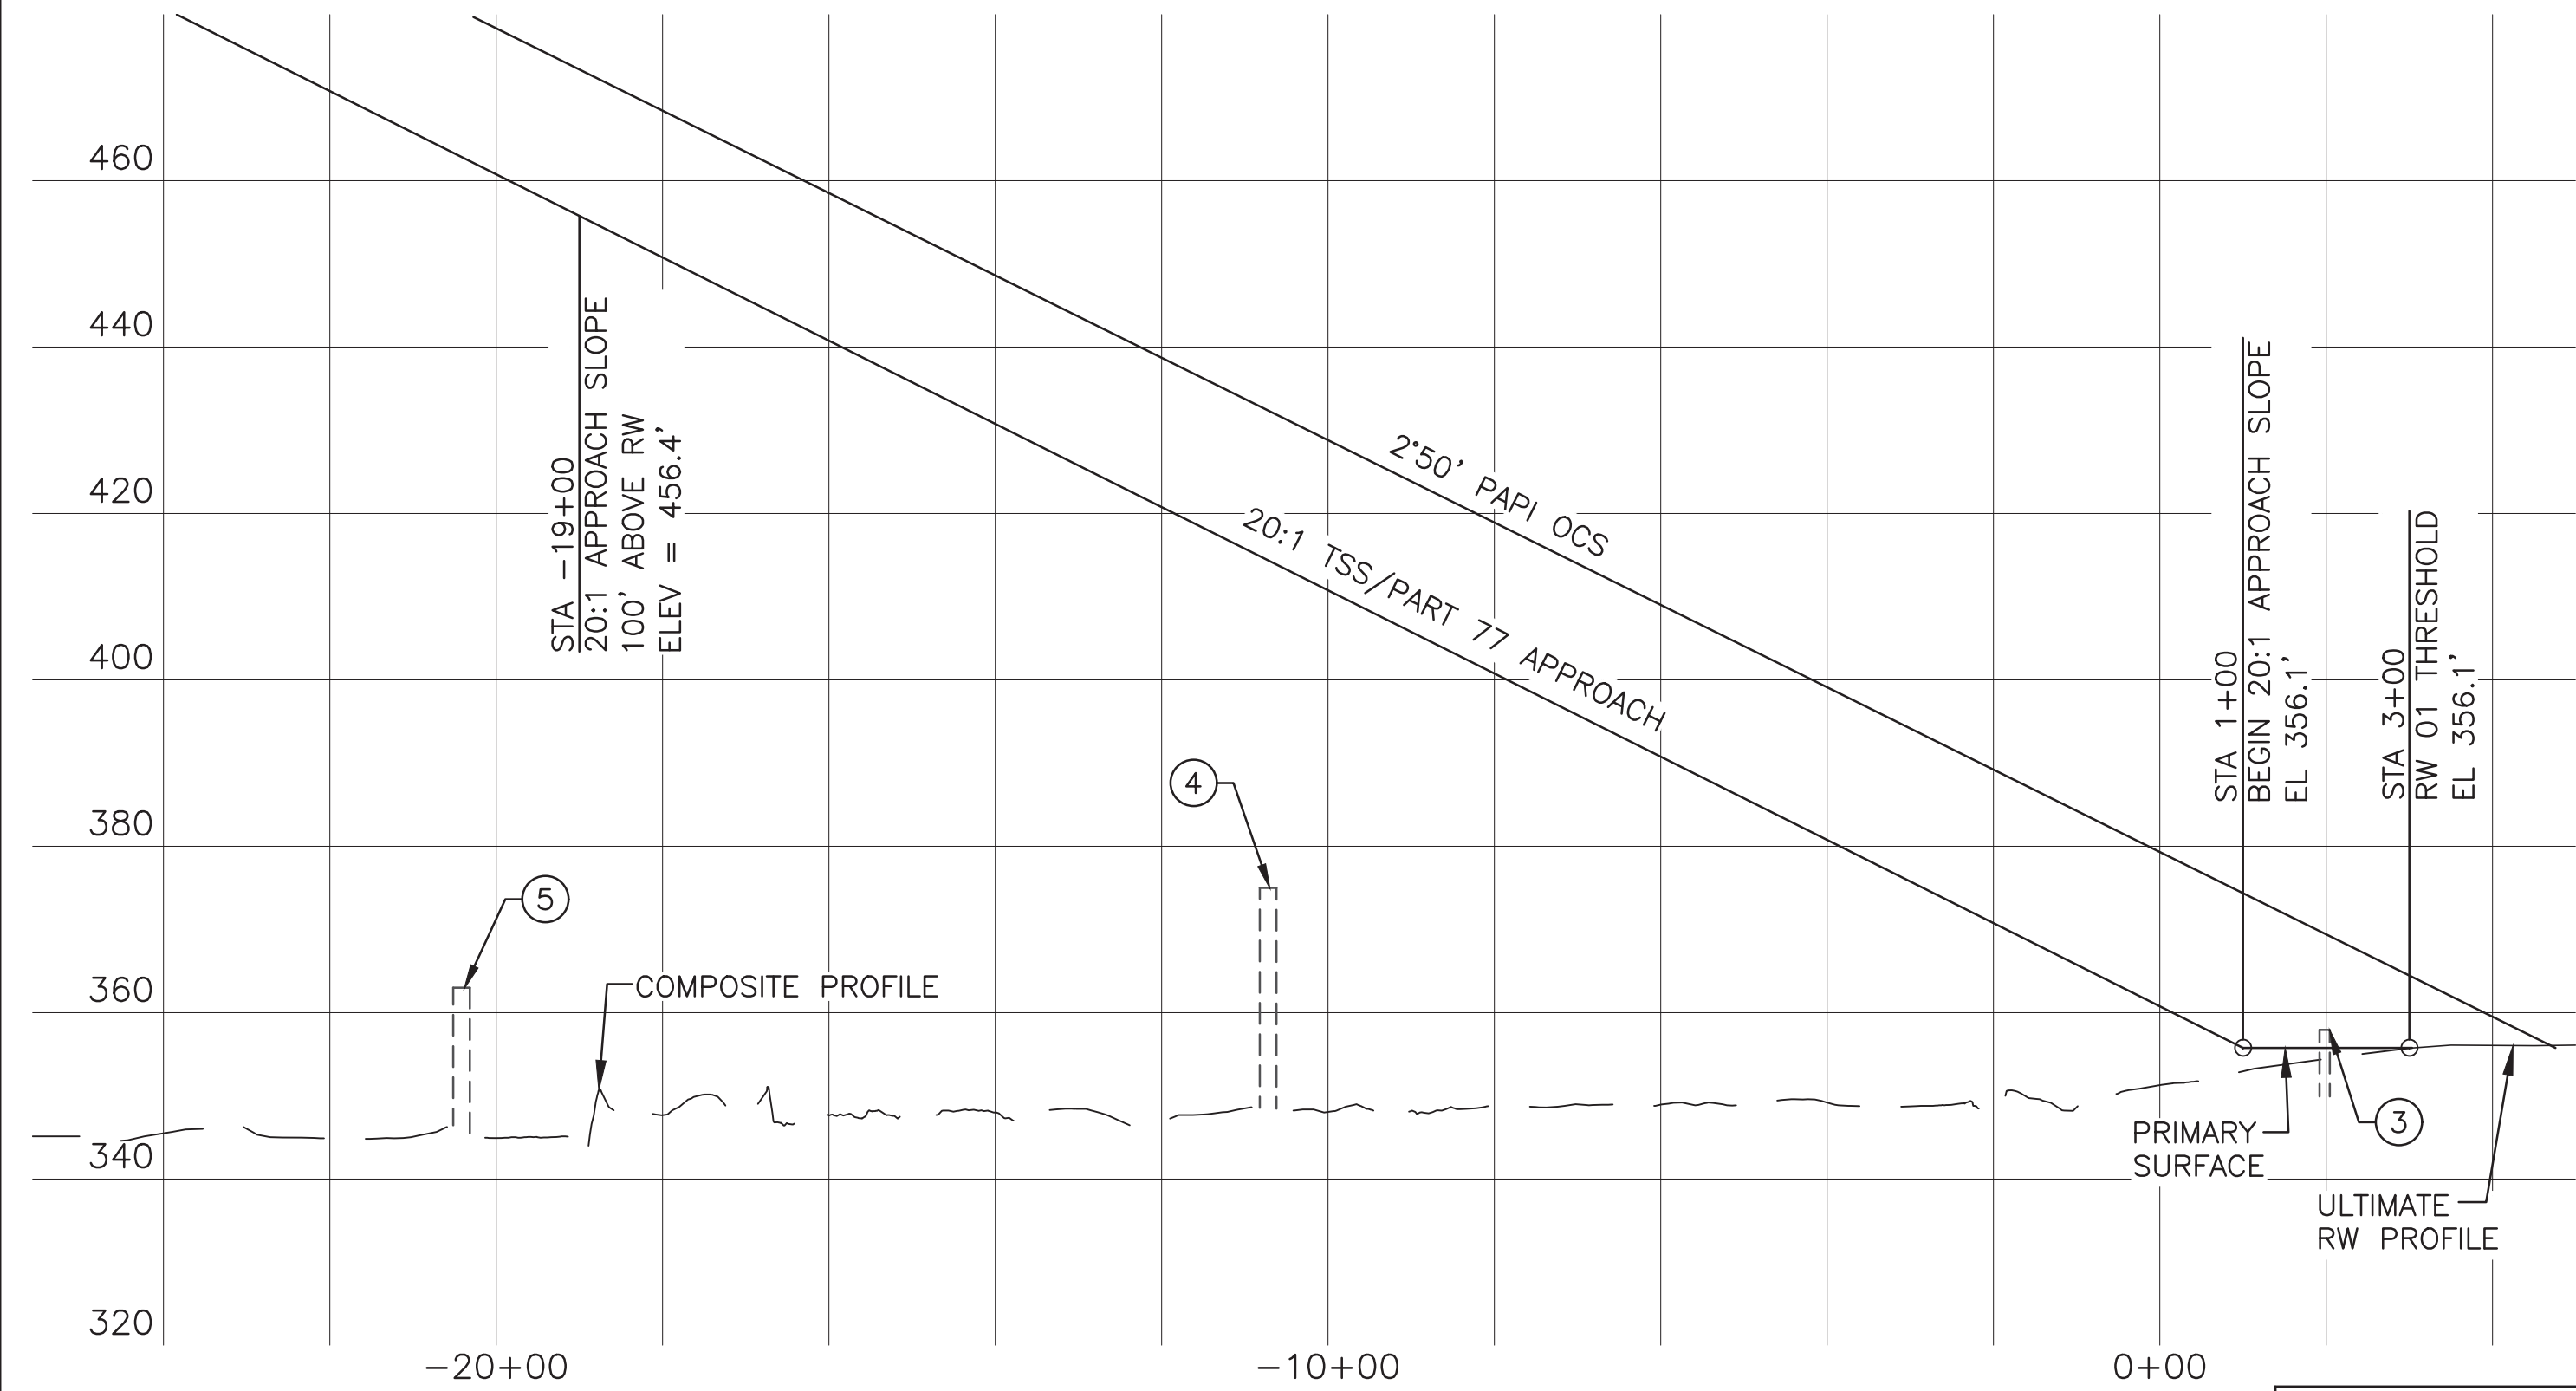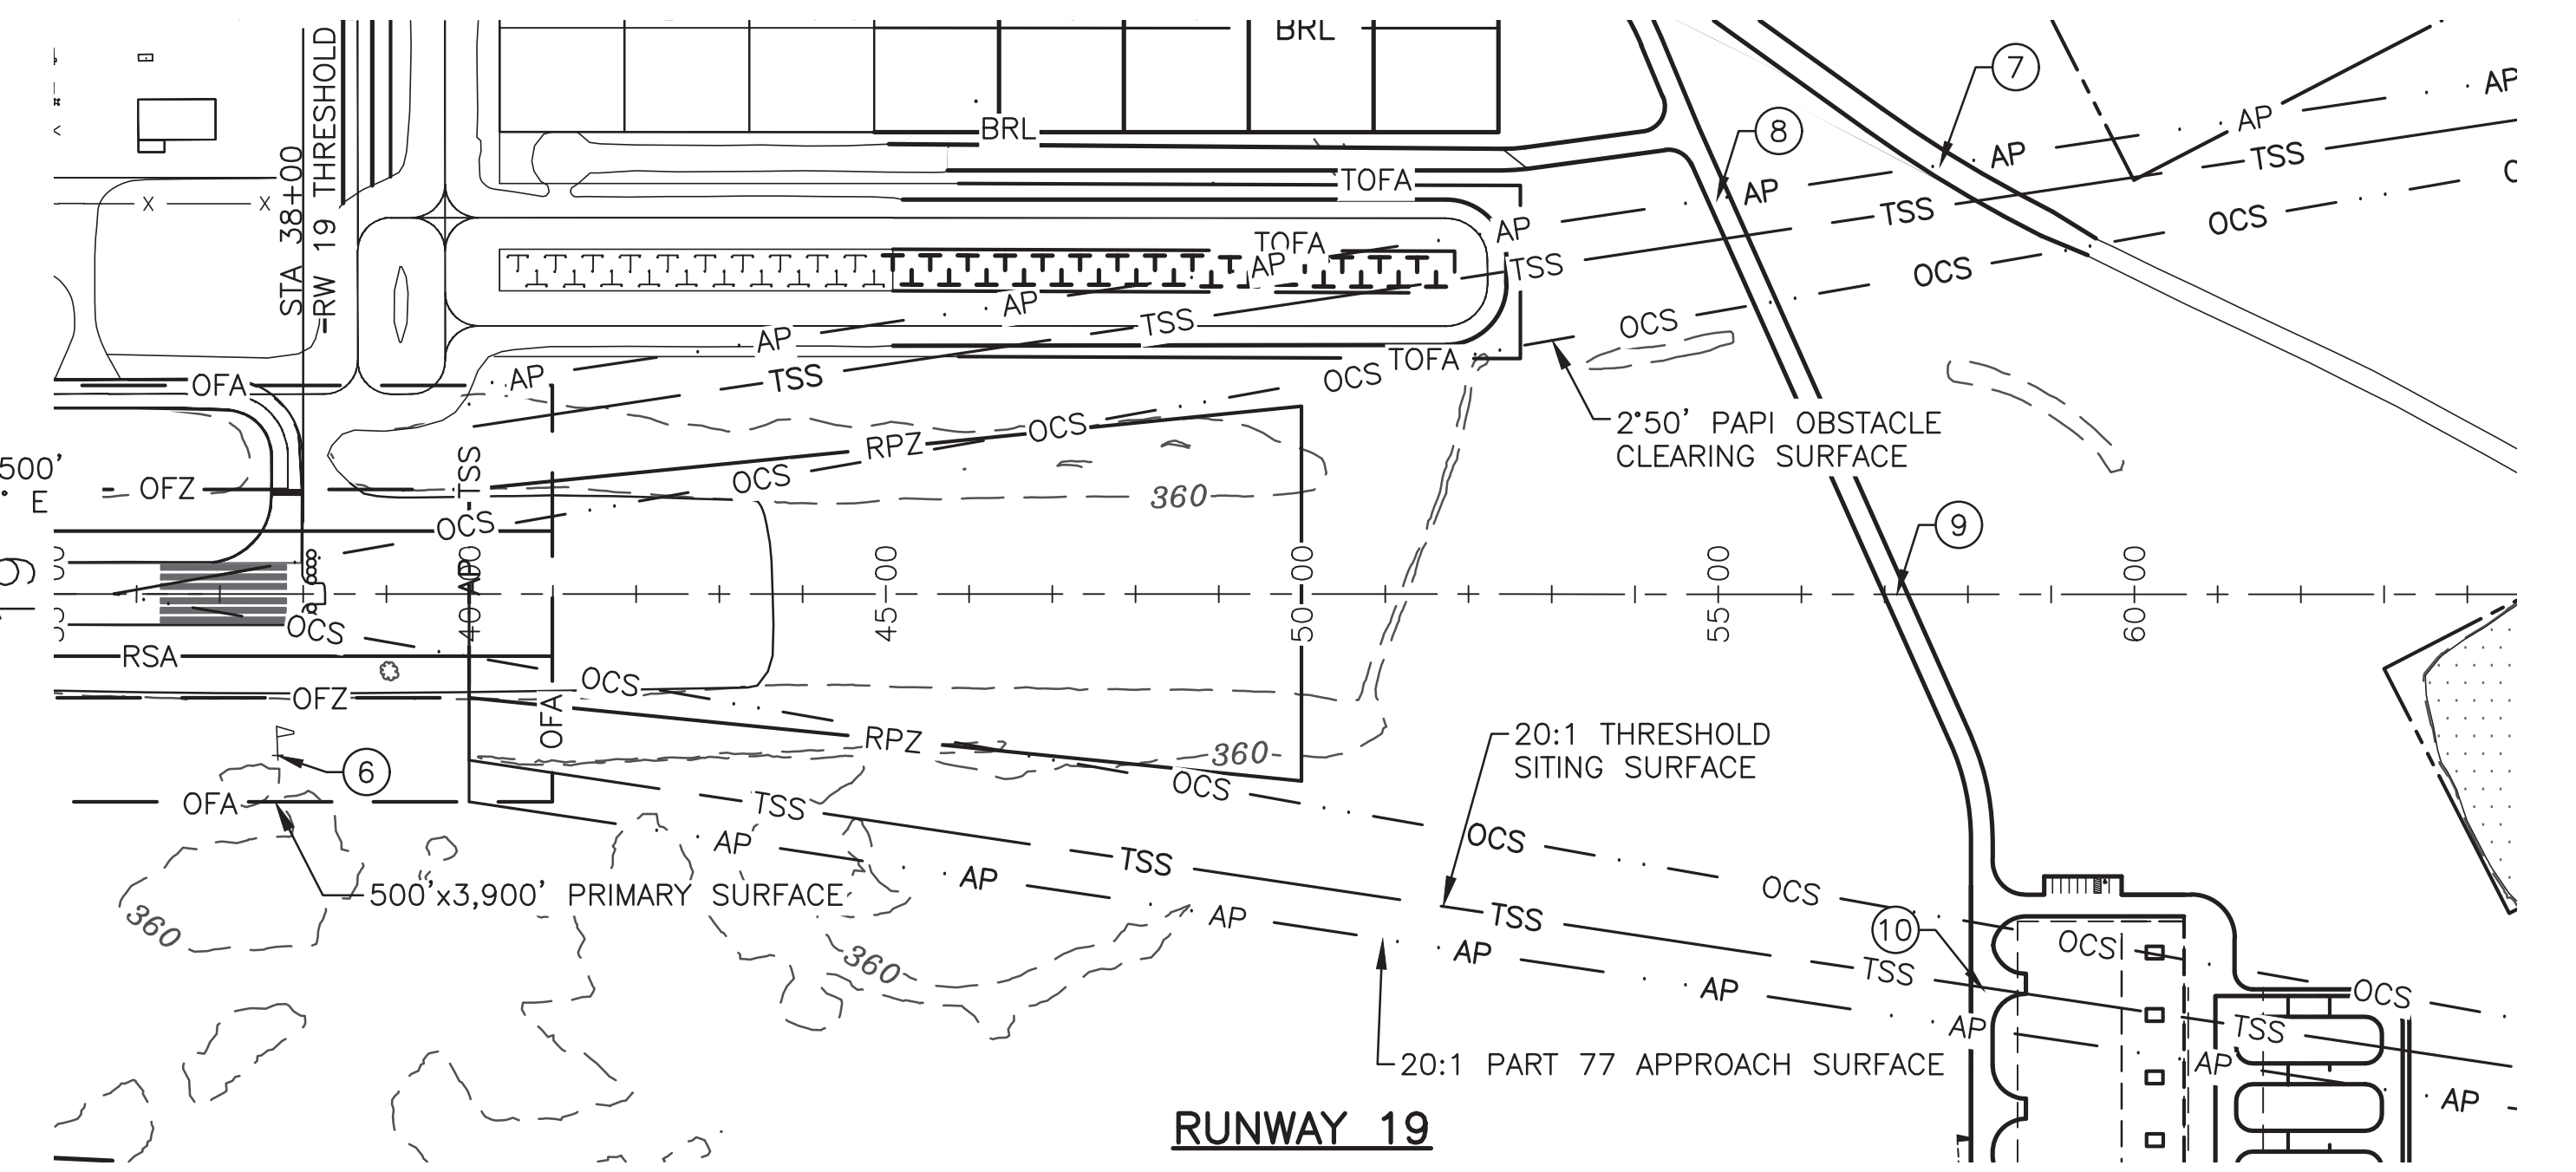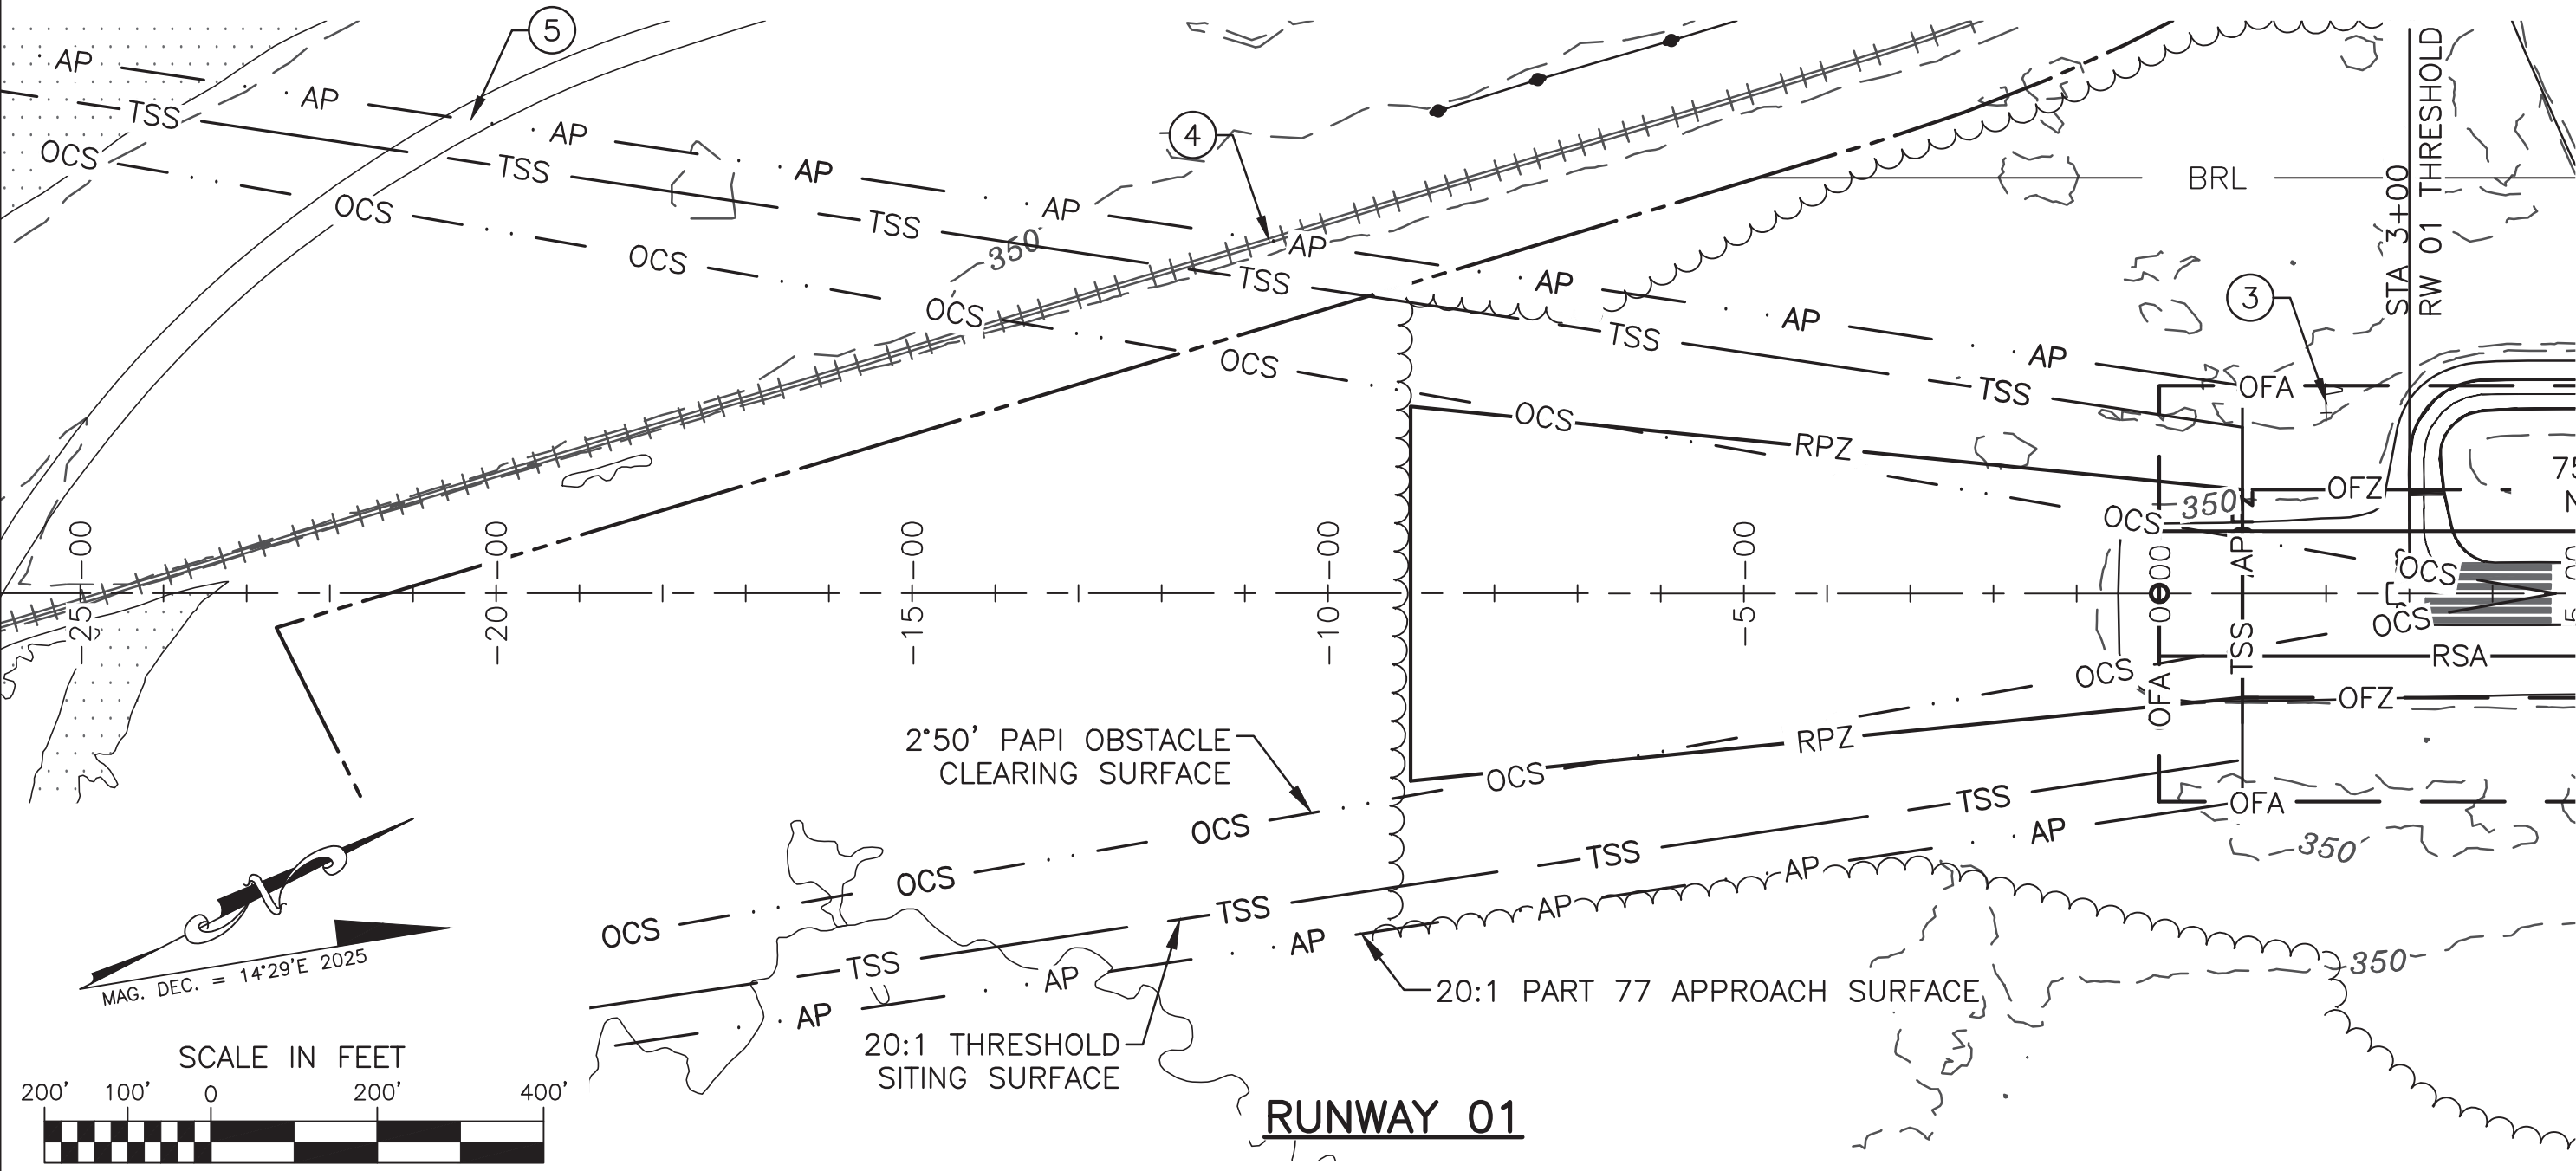

ID#	DESCRIPTION	STATION/OFFSET	BASE EL	TOP EL	SURFACE PENETRATED	SURFACE EL	AMOUNT PENETRATED	DISPOSITION	STAGE TO CORRECT
3	UNLIGHTED WINDCONE	2+00/210'L	350'	358'	PRIMARY	356'	2'	TO REMAIN	ULTIMATE
4	RAILROAD + 23'	-10+72/421'L	352'	375'	NONE	415'	-40'	TO REMAIN	N/A
5	ROAD + 15'	-20+43/568'L	348'	363'	NONE	472'	-109'	TO REMAIN	N/A

ID#	DESCRIPTION	STATION/OFFSET	BASE EL	TOP EL	SURFACE PENETRATED	SURFACE EL	AMOUNT PENETRATED	DISPOSITION	STAGE TO CORRECT
6	UNLIGHTED WINDCONE	37+70/202'R	359'	367'	PRIMARY	365'	2'	TO REMAIN	N/A
7	ROAD + 15'	57+48/515'L	365'	380'	NONE	454'	-74'	TO REMAIN	N/A
8	ROAD + 15'	55+00/475'L	365'	380'	NONE	440'	-60'	TO REMAIN	N/A
9	ROAD + 15'	57+15/CL	365'	380'	NONE	450'	-70'	TO REMAIN	N/A
10	ROAD + 15'	58+21/520'R	366'	381'	NONE	455'	-74'	TO REMAIN	N/A

(HP) = HIGH POINT OF OBSTRUCTION AREA.

- NOTES:**
- REFER TO THE AIRPORT AIRSPACE DRAWING FOR PENETRATIONS OF THE OUTER APPROACH SURFACES.
 - MAPPING SHOWN ON THIS SHEET IS THE COMBINED TOPOGRAPHIC SURVEY AND CONTROLLED AERIAL MAPPING.
 - THRESHOLD SITING IS DEFINED PER ENGINEERING BRIEF #99, TABLE 3-2, RUNWAY TYPE 4.
 - OBSTRUCTIONS LISTED IN THE PART 77 SURFACE OBSTRUCTION TABLE ALSO PENETRATE THRESHOLD SITING SURFACE BY THE SAME MAGNITUDE.
 - THE MOVEABLE OBJECT HEIGHT IS 15' FOR ROADS AND 23' FOR RAILROADS.


- NOTES:**
- REFER TO THE AIRPORT AIRSPACE DRAWING FOR PENETRATIONS OF THE OUTER APPROACH SURFACES.
 - MAPPING SHOWN ON THIS SHEET IS THE COMBINED TOPOGRAPHIC SURVEY AND CONTROLLED AERIAL MAPPING.
 - THRESHOLD SITING IS DEFINED PER ENGINEERING BRIEF #99, TABLE 3-2, RUNWAY TYPE 4.
 - OBSTRUCTIONS LISTED IN THE PART 77 SURFACE OBSTRUCTION TABLE ALSO PENETRATE THRESHOLD SITING SURFACE BY THE SAME MAGNITUDE.
 - THE MOVEABLE OBJECT HEIGHT IS 15' FOR ROADS AND 23' FOR RAILROADS.

BY	DATE	REVISION



STATE OF ALASKA
DEPARTMENT OF TRANSPORTATION
AND PUBLIC FACILITIES
CENTRAL REGION

TALKEETNA AIRPORT
 TALKEETNA, ALASKA
 AIRPORT LAYOUT PLAN
 ULTIMATE INNER PORTION OF
 THE APPROACH SURFACE -
 RUNWAY 1-19

DATE:
 5/20/2020
 SHEET:
 13
 OF
 20

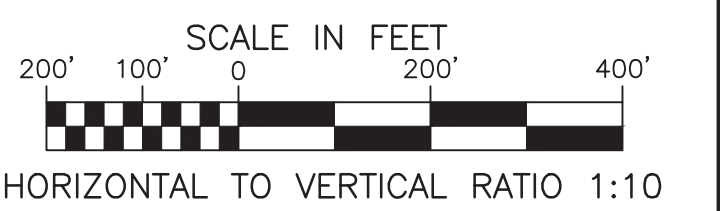

Designed By: LEN
 Drawn By: ADC
 Checked By: MMS
 Date: 15/05/2020, 2:59 PM
 Location: U:\2017\02282\Talkheetna\Drawings\2019\Sheets\ALP-TKA-12-14_E-APPROCH-SURF.dwg
 File Name: U:\2017\02282\Talkheetna\Drawings\2019\Sheets\ALP-TKA-12-14_E-APPROCH-SURF.dwg

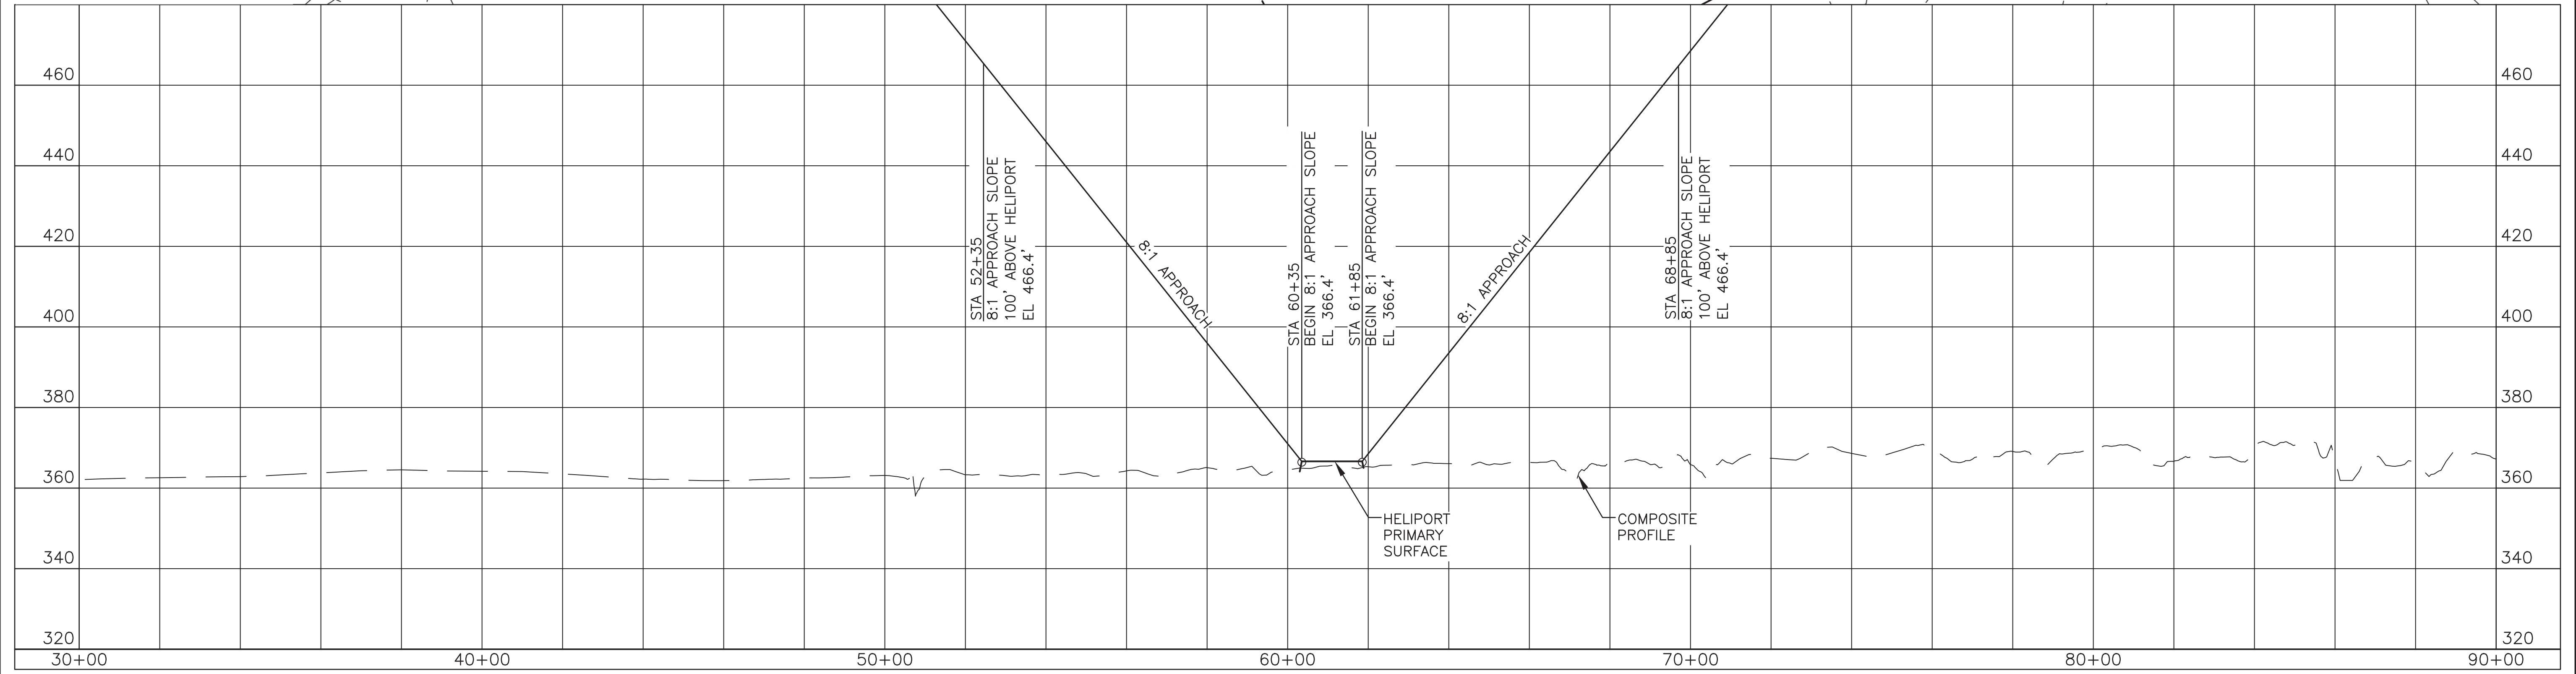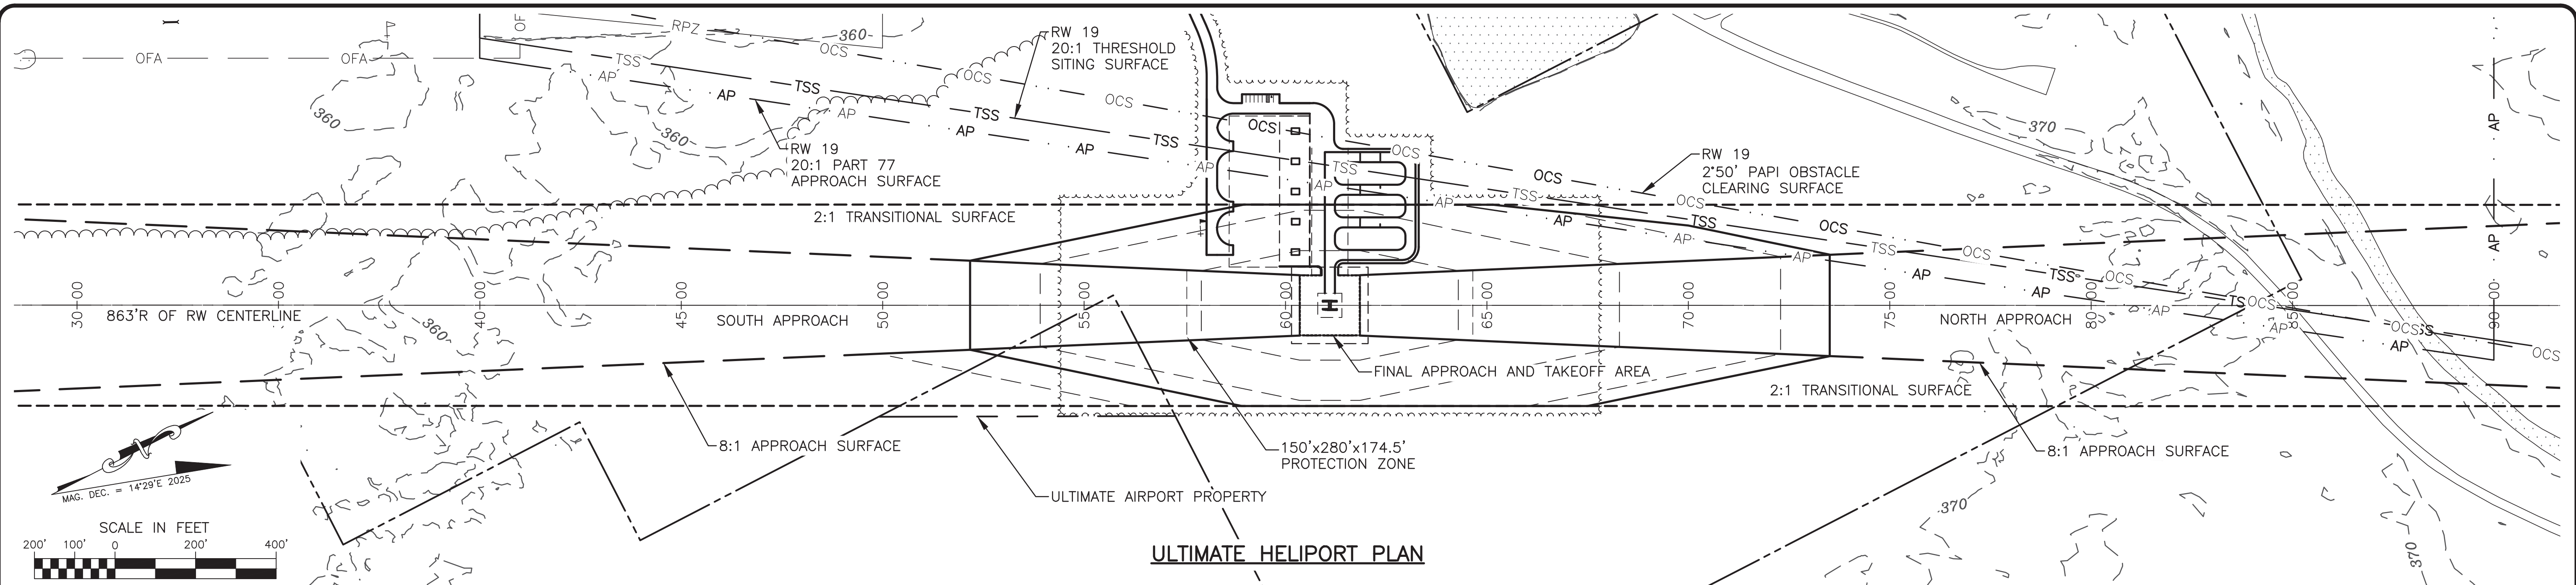

SOUTH APPROACH PROFILE

NORTH APPROACH PROFILE

PART 77 SURFACE OBSTRUCTION TABLE (INNER PORTION SOUTH)									
ID#	DESCRIPTION	STATION/OFFSET	BASE EL	TOP EL	SURFACE PENETRATED	SURFACE EL	AMOUNT PENETRATED	DISPOSITION	STAGE TO CORRECT
	NONE								


PART 77 SURFACE OBSTRUCTION TABLE (INNER PORTION NORTH)									
ID#	DESCRIPTION	STATION/OFFSET	BASE EL	TOP EL	SURFACE PENETRATED	SURFACE EL	AMOUNT PENETRATED	DISPOSITION	STAGE TO CORRECT
	NONE								

NOTES:

1. THERE WILL BE NO PART 77 OBSTRUCTIONS IN THE SOUTH APPROACH, TREES WILL BE CLEARED PRIOR TO HELIPORT CONSTRUCTION.
2. THE CONTROLLING OBSTRUCTION FOR THE SOUTH APPROACH TO THE HELIPORT WILL BE DETERMINED AFTER TREE CLEARING.
3. HELIPORT APPROACH SURFACES ARE DEFINED PER AC 150/5390-2C, CHAPTER 2.

NOTES:

1. THERE WILL BE NO PART 77 OBSTRUCTIONS IN THE NORTH APPROACH, TREES WILL BE CLEARED PRIOR TO HELIPORT CONSTRUCTION.
2. THE CONTROLLING OBSTRUCTION FOR THE NORTH APPROACH TO THE HELIPORT WILL BE DETERMINED AFTER TREE CLEARING.
3. HELIPORT APPROACH SURFACES ARE DEFINED PER AC 150/5390-2C, CHAPTER 2.

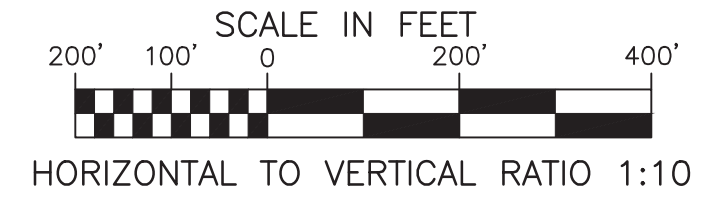

BY	DATE	REVISION





STATE OF ALASKA
DEPARTMENT OF TRANSPORTATION
AND PUBLIC FACILITIES
CENTRAL REGION

TALKEETNA AIRPORT
 TALKEETNA, ALASKA
 AIRPORT LAYOUT PLAN

ULTIMATE INNER PORTION OF
 THE APPROACH SURFACE - HELIPORT

DATE:
 5/20/2020
 SHEET:
 14
 OF
 20

Date Plotted: 15/19/2020 1:30 PM
 User: L5_DEPARTURE_SURF_RW_1-19
 File Name: U:\2019\Projects\Talkeetna\Drawings\ALP-15_E-DEP-SURF.dwg
 Designed By: LEN
 Drawn By: ABC
 Checked By: MMS

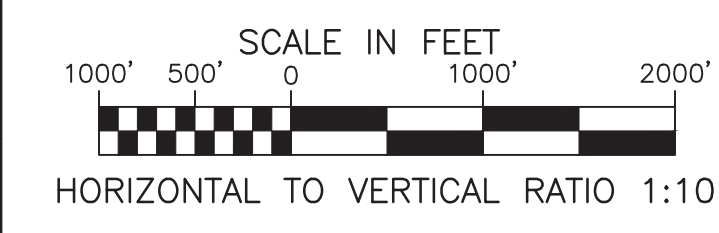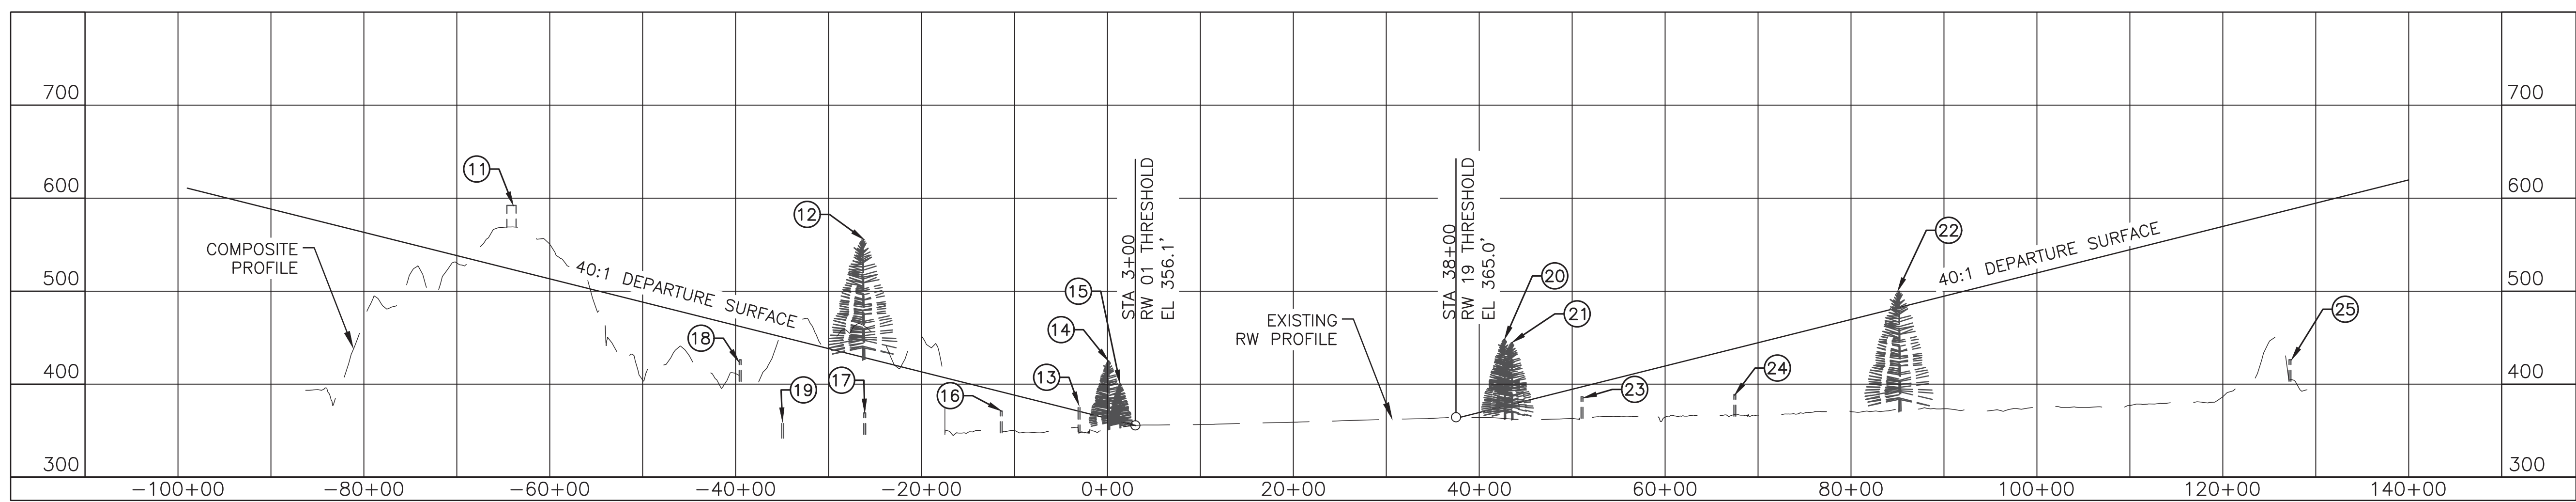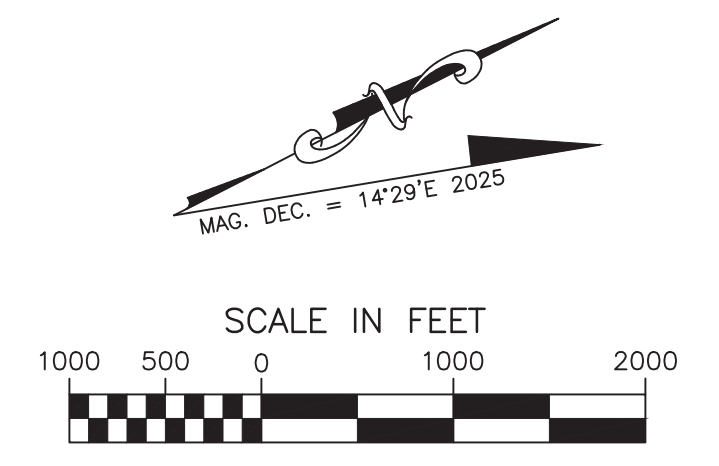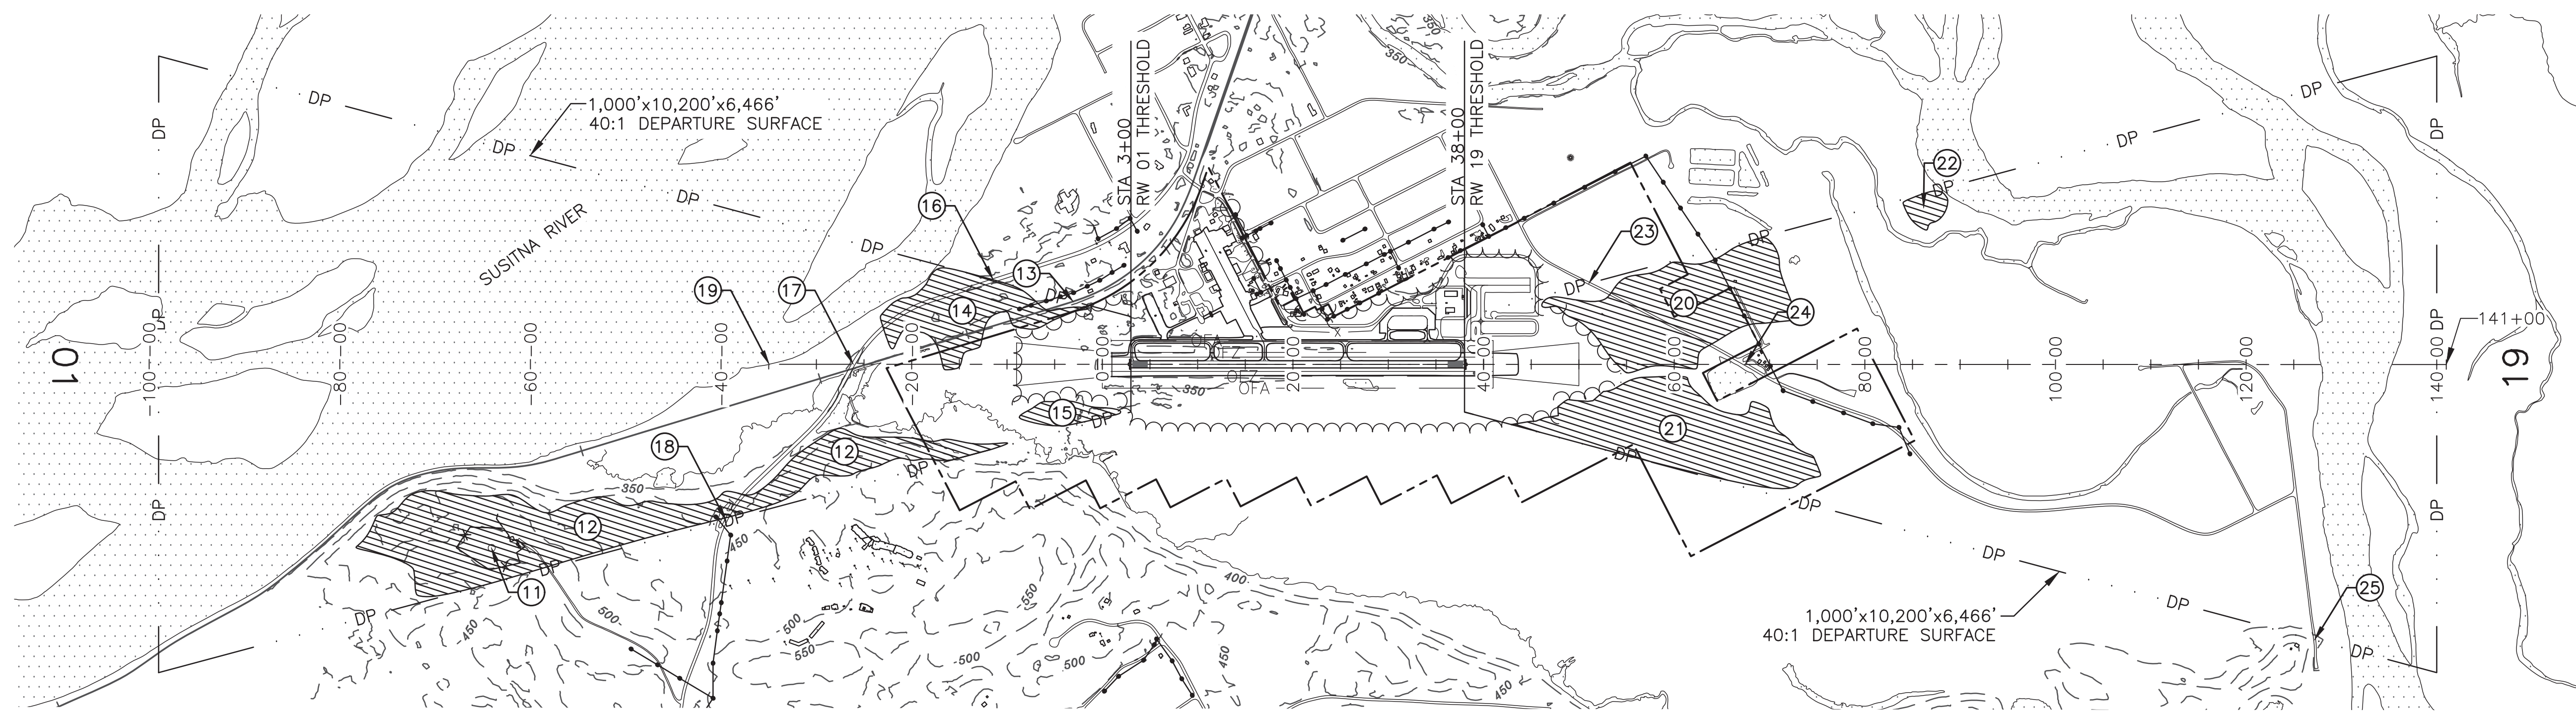

ID#	DESCRIPTION	STATION/OFFSET	BASE ELEV	TOP ELEV	SURFACE PENETRATED	SURFACE ELEVATION	AMOUNT PENETRATED	DISPOSITION	STAGE TO CORRECT
11	BUILDINGS (HP)	-64+07/1,927'R	569'	592'	DEPARTURE	524'	68'	TO REMAIN	N/A
12	TERRAIN/TREES (HP)	-26+50/1,145'R	454'	549'	DEPARTURE	429'	120'	REMOVE	ULTIMATE
13	RAILROAD + 23'	-3+05/659'L	354'	377'	DEPARTURE	371'	6'	TO REMAIN	N/A
14	TREES (HP)	0+33/538'L	350'	413'	DEPARTURE	350'	63'	REMOVE	ULTIMATE
15	TREES (HP)	1+27/477'R	351'	401'	DEPARTURE	360'	41'	REMOVE	ULTIMATE
16	ROAD + 15'	-11+47/880'L	351'	366'	NONE	392'	-26'	TO REMAIN	N/A
17	ROAD + 15'	-26+13/CL	352'	367'	NONE	429'	-62'	TO REMAIN	N/A
18	ROAD + 15'	-39+49/1,639'L	408'	423'	NONE	462'	-39'	TO REMAIN	N/A
19	RIVER + 10'	-35+00/CL	331'	341'	NONE	451'	-110'	TO REMAIN	N/A

ID#	DESCRIPTION	STATION/OFFSET	BASE ELEV	TOP ELEV	SURFACE PENETRATED	SURFACE ELEVATION	AMOUNT PENETRATED	DISPOSITION	STAGE TO CORRECT
20	TREES (HP)	42+76/539'L	357'	448'	DEPARTURE	376'	72'	REMOVE	ULTIMATE
21	TREES (HP)	43+25/633'R	361'	445'	DEPARTURE	378'	67'	REMOVE	ULTIMATE
22	TREES (HP)	85+11/1,516'L	368'	501'	DEPARTURE	483'	18'	REMOVE	ULTIMATE
23	ROAD + 15'	51+16/847'L	364'	379'	NONE	397'	-18'	TO REMAIN	N/A
24	ROAD + 15'	65+45/CL	367'	382'	NONE	445'	-63'	TO REMAIN	N/A
25	ROAD + 15'	127+21/2,890'R	405'	415'	NONE	588'	-168'	TO REMAIN	N/A

(HP) = HIGH POINT OF OBSTRUCTION AREA.

LEGEND
 DEPARTURE SURFACE PENETRATIONS

(HP) = HIGH POINT OF OBSTRUCTION AREA.

NOTES:

- MAPPING SHOWN ON THIS SHEET IS THE COMBINED TOPOGRAPHIC SURVEY AND CONTROLLED AERIAL MAPPING.
- DEPARTURE SURFACES ARE DEFINED PER AC 150/5300-13A TABLE 3-2, LINE 7 (FIGURE 3-4).
- DEPARTURE SURFACES ARE LABELED BASED ON RW DIRECTION OF DEPARTURE.
- THE MOVEABLE OBJECT HEIGHT IS 15' FOR ROADS, 23' FOR RAILROADS, AND 10' FOR RIVERS.

BY	DATE	REVISION

**STATE OF ALASKA
 DEPARTMENT OF TRANSPORTATION
 AND PUBLIC FACILITIES
 CENTRAL REGION**



TALKEETNA AIRPORT
 TALKEETNA, ALASKA
 AIRPORT LAYOUT PLAN

EXISTING DEPARTURE SURFACES -
 RUNWAY 1-19

DATE:
5/19/2020
 SHEET:
15
 OF
20

Designed By: LEN
 Drawn By: ABC
 Checked By: MMS

Date Plotted: 15/19/2020, 3:42 PM
 User: 15/19/2020 3:42 PM
 File Name: U:\2019\2020\Talkheetna\AAs-Built-ALP-2019\Sheets\ALP-TKA-16_UJ-DEP-SURF.dwg

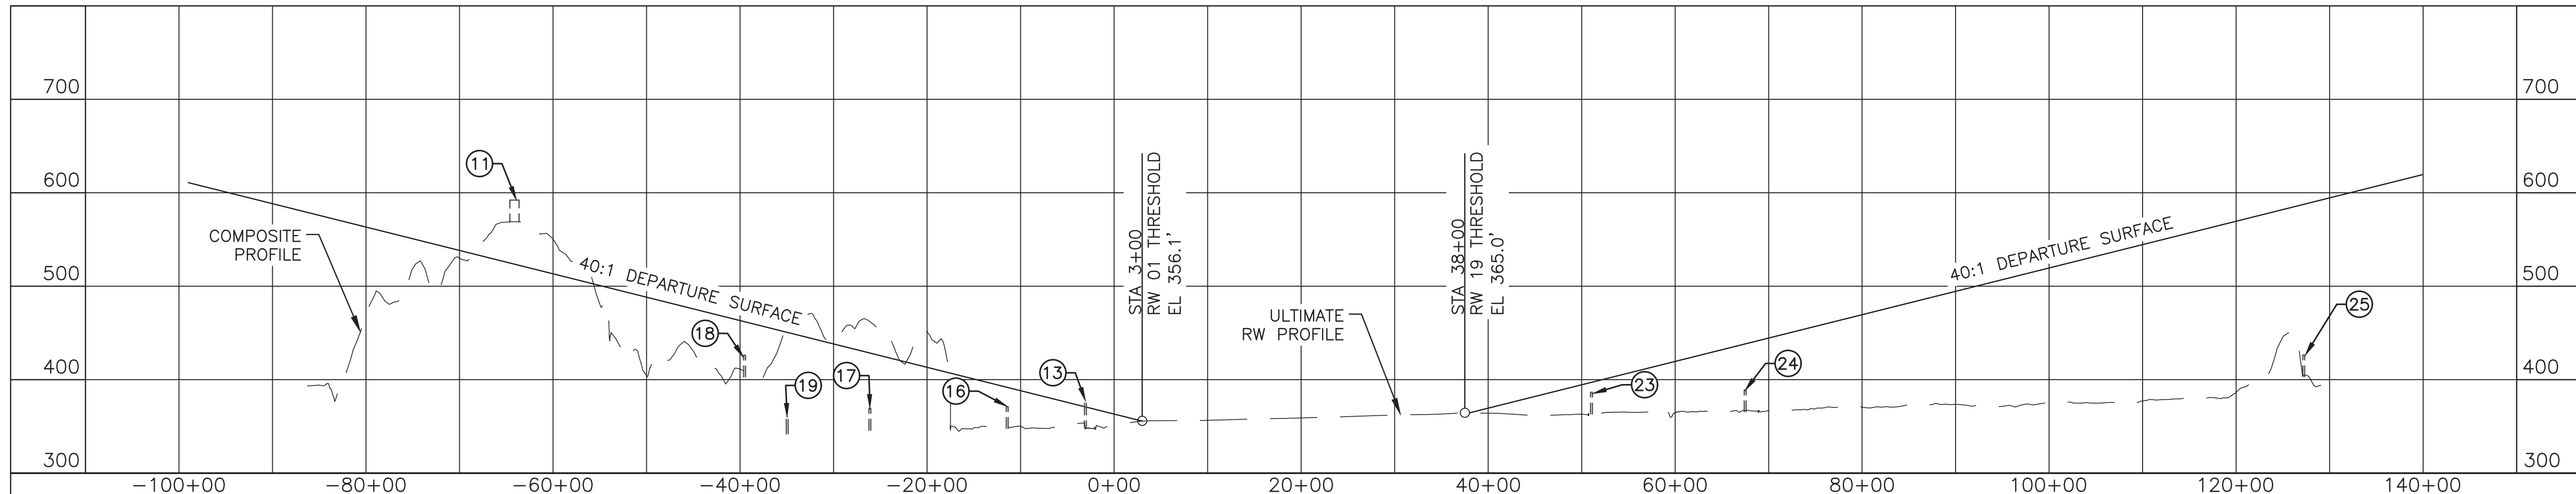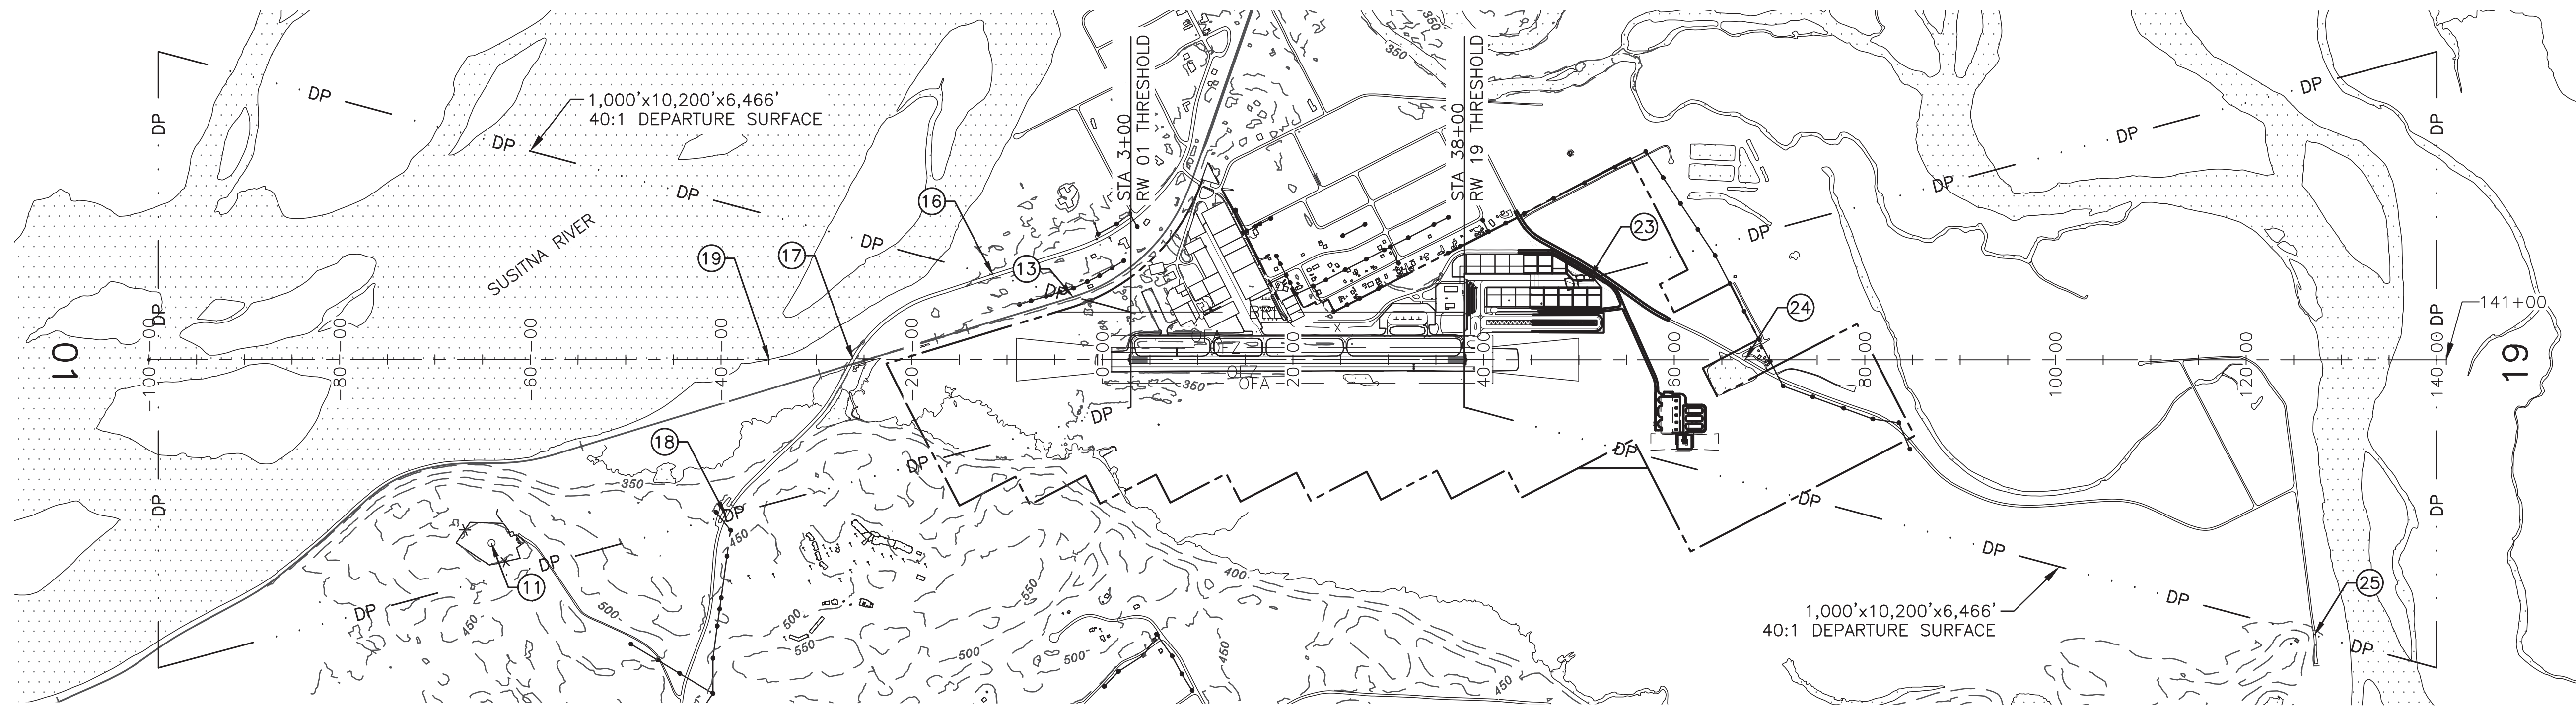

ID#	DESCRIPTION	STATION/OFFSET	BASE ELEV	TOP ELEV	SURFACE PENETRATED	SURFACE ELEVATION	AMOUNT PENETRATED	DISPOSITION	STAGE TO CORRECT
11	BUILDINGS (HP)	-64+07/1,927'R	569'	592'	DEPARTURE	524'	68'	TO REMAIN	N/A
13	RAILROAD + 23'	-3+05/659'L	354'	377'	DEPARTURE	371'	6'	TO REMAIN	N/A
16	ROAD + 15'	-11+47/880'L	351'	366'	NONE	392'	-26'	TO REMAIN	N/A
17	ROAD + 15'	-26+13/CL	352'	367'	NONE	429'	-62'	TO REMAIN	N/A
18	ROAD + 15'	-39+49/1,639'L	408'	423'	NONE	462'	-39'	TO REMAIN	N/A
19	RIVER + 10'	-35+00/CL	331'	341'	NONE	451'	-110'	TO REMAIN	N/A

ID#	DESCRIPTION	STATION/OFFSET	BASE ELEV	TOP ELEV	SURFACE PENETRATED	SURFACE ELEVATION	AMOUNT PENETRATED	DISPOSITION	STAGE TO CORRECT
23	ROAD + 15'	51+16/847'L	364'	379'	NONE	397'	-18'	TO REMAIN	N/A
24	ROAD + 15'	65+45/CL	367'	382'	NONE	445'	-63'	TO REMAIN	N/A
25	ROAD + 15'	127+21/2,890'R	405'	415'	NONE	588'	-168'	TO REMAIN	N/A

(HP) = HIGH POINT OF OBSTRUCTION AREA.

LEGEND

DEPARTURE SURFACE PENETRATIONS

- NOTES:**
- MAPPING SHOWN ON THIS SHEET IS THE COMBINED TOPOGRAPHIC SURVEY AND CONTROLLED AERIAL MAPPING.
 - DEPARTURE SURFACES ARE DEFINED PER AC 150/5300-13A TABLE 3-2, LINE 7 (FIGURE 3-4).
 - DEPARTURE SURFACES ARE LABELED BASED ON RW DIRECTION OF DEPARTURE.
 - THE MOVEABLE OBJECT HEIGHT IS 15' FOR ROADS, 23' FOR RAILROADS, AND 10' FOR RIVERS.


BY	DATE	REVISION

**STATE OF ALASKA
 DEPARTMENT OF TRANSPORTATION
 AND PUBLIC FACILITIES
 CENTRAL REGION**

TALKEETNA AIRPORT
 TALKEETNA, ALASKA
 AIRPORT LAYOUT PLAN
 ULTIMATE DEPARTURE SURFACES -
 RUNWAY 1-19

DATE: 5/19/2020
 SHEET: 16 OF 20

Date Plotted: 15/19/2020, 2:13 PM
 User: U:\2019\Sheet3\ALP-TA-17-18_AIRSPACE_PART77.dwg
 File Name: U:\2019\Sheet3\ALP-TA-17-18_AIRSPACE_PART77.dwg
 Designed By: LEN
 Drawn By: ABC
 Checked By: MMS

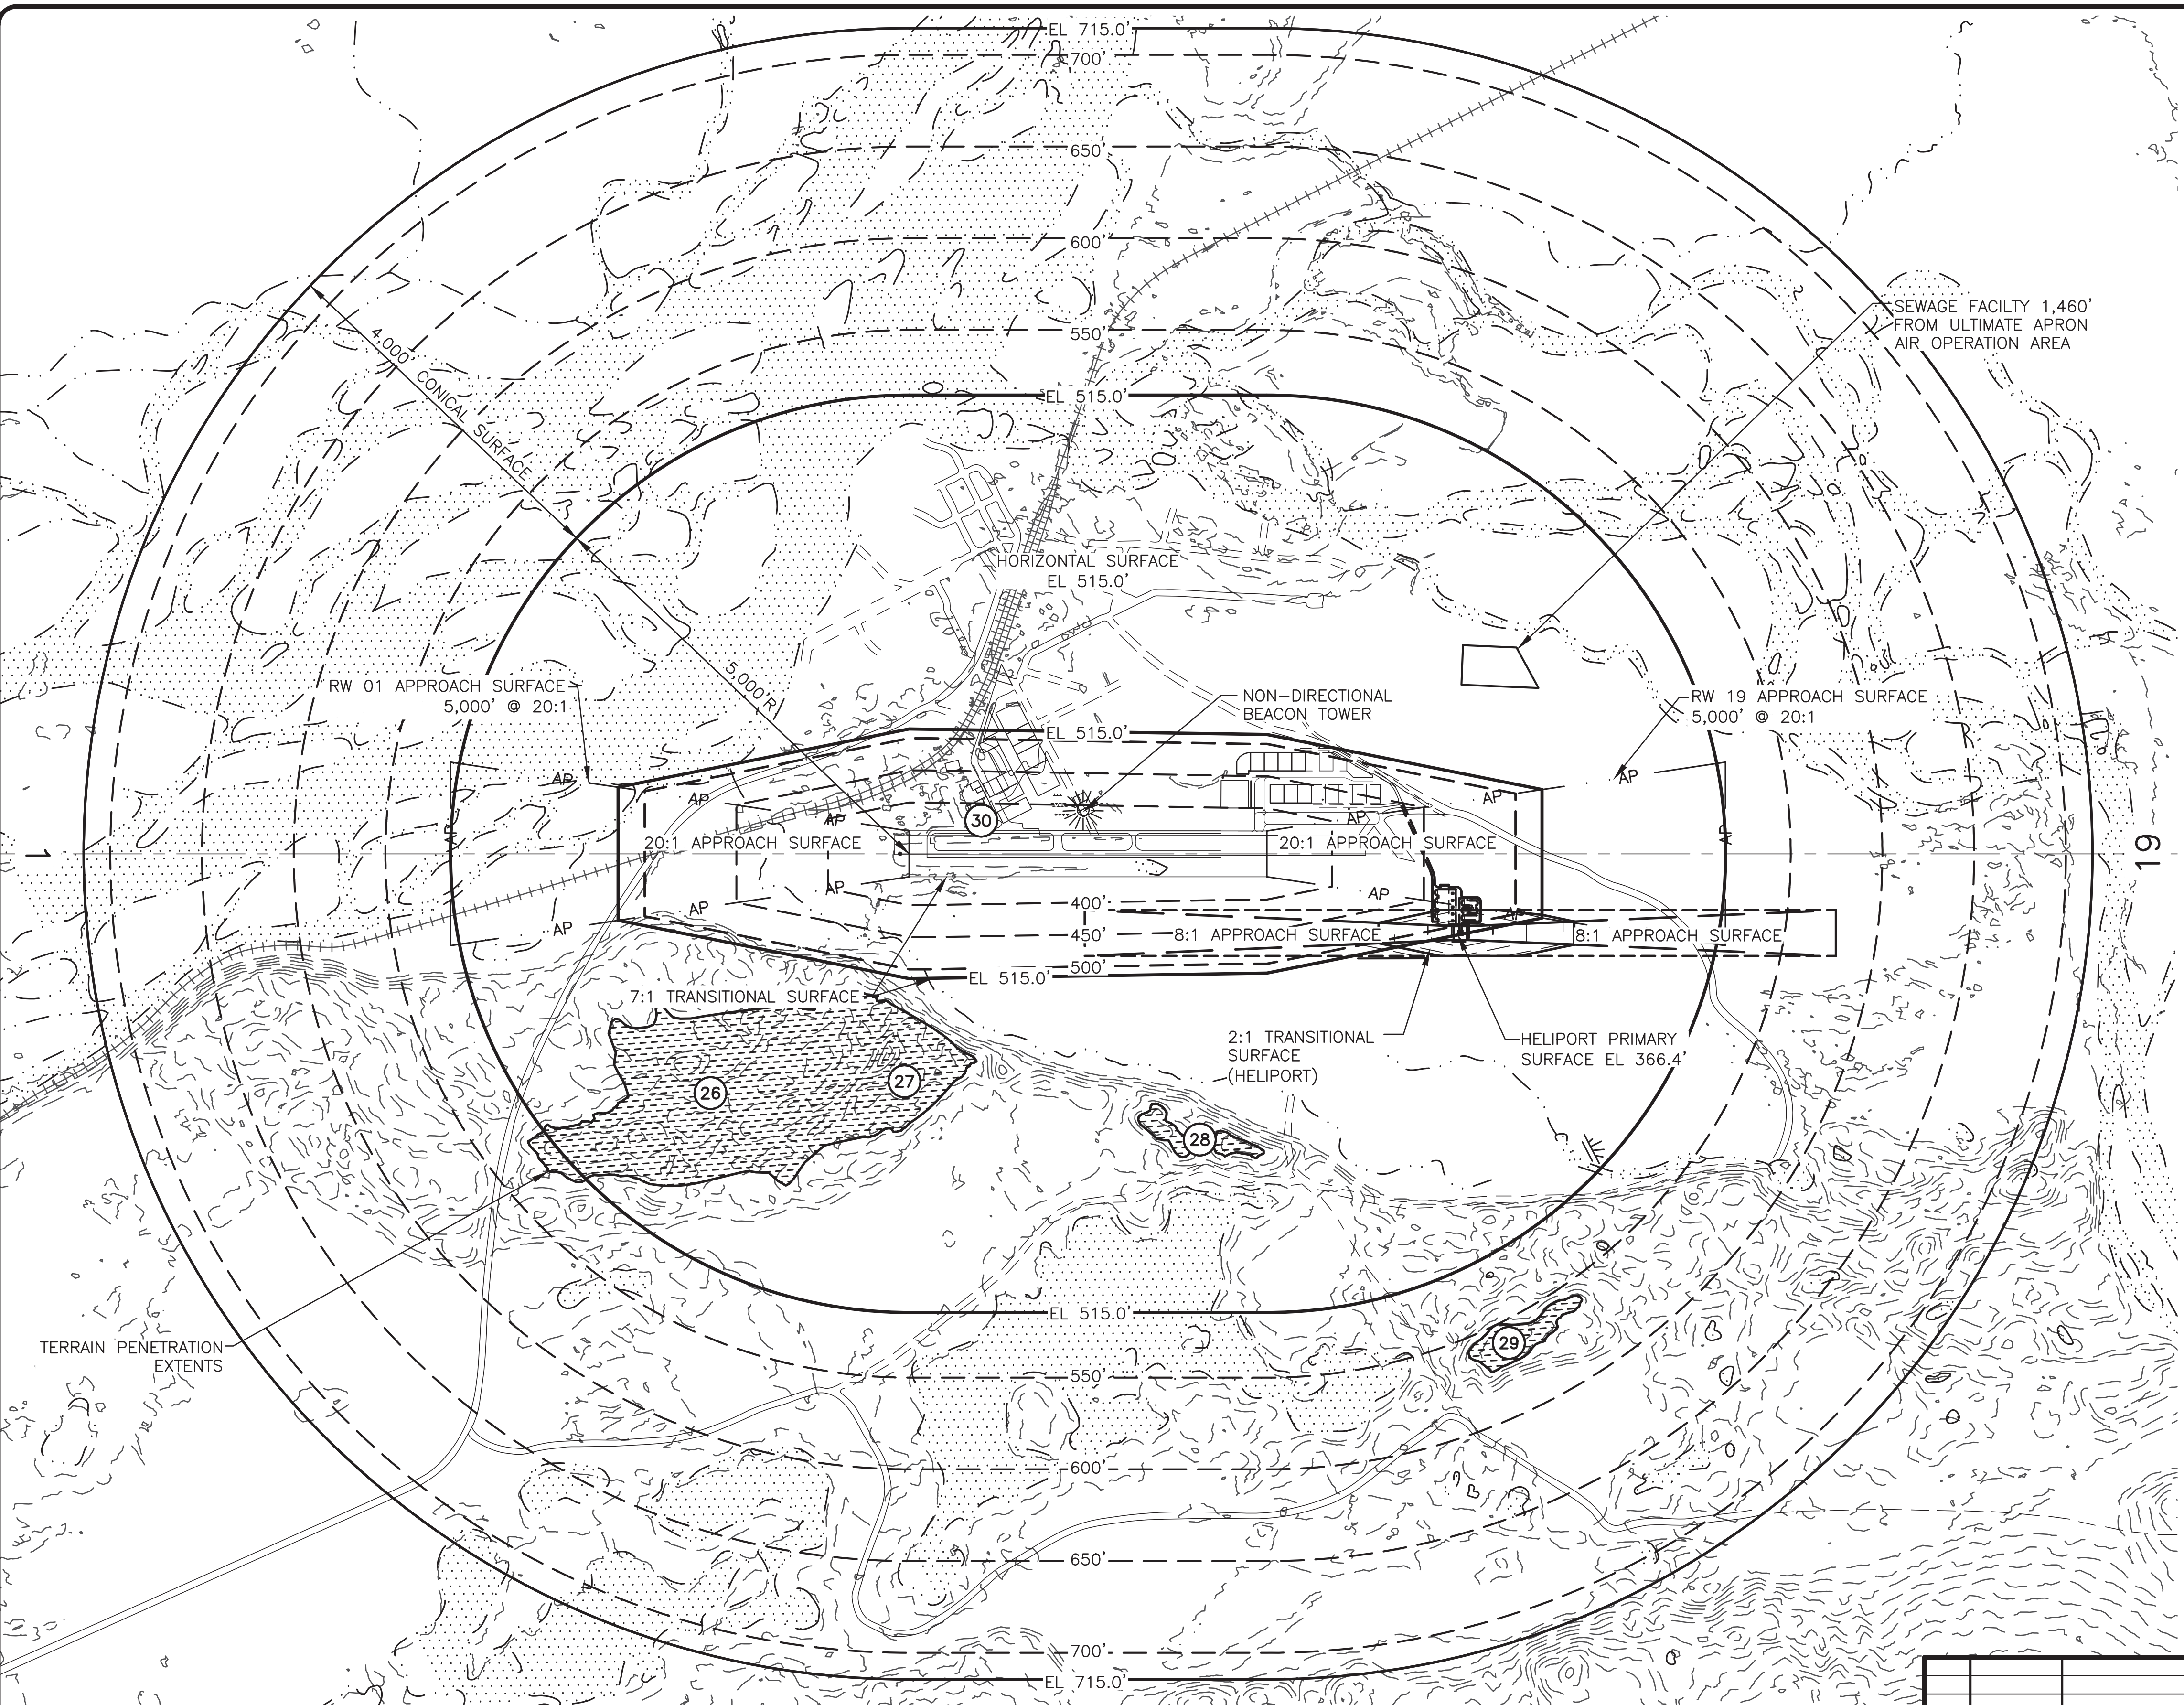

LEGEND

F.A.R. PART 77 SURFACE PENETRATIONS

- NOTES:**
- AIRPORT ELEVATION IS 365.0' (NAVD 88). HELIPORT PRIMARY SURFACE ELEVATION IS 366.4' (NAVD 88).
 - RUNWAY APPROACH SURFACES ARE 20:1 BEGINNING 200' BEYOND THE THRESHOLD.
 - PROFILES ARE SHOWN ON SHEET 14. REFER TO THE INNER PORTION OF THE APPROACH SURFACE DRAWINGS, SHEETS 9-11 FOR CLOSE-IN OBSTRUCTIONS.
 - PRIMARY SURFACE WIDTH IS 500'.
 - LOCAL HEIGHT ZONING RESTRICTIONS REQUIRE NO STRUCTURE TALLER THAN 85' WITHOUT A PERMIT.
 - HELIPORT APPROACH SURFACES ARE 8:1, HELIPORT TRANSITIONAL SURFACES ARE 2:1.
 - GROUND SURVEY WAS PERFORMED BY STANTEC DURING AUGUST 1-7, 2018. NO AERIAL MAPPING WAS PERFORMED THIS SURVEY. AERIAL MAPPING WAS PERFORMED BY KODIAK MAPPING USING IMAGERY COLLECTED AUGUST 23, 2014. SURVEYED DATA WAS REVIEWED TO ENSURE THAT ALL INFORMATION MEETS THE ACCURACY REQUIREMENTS ESTABLISHED IN AC 150/4300-18B.

PART 77 SURFACE OBSTRUCTIONS TABLE (OUTER PORTION)

ID#	DESCRIPTION	STATION/OFFSET	BASE ELEV	TOP ELEV	SURFACE PENETRATED	SURFACE ELEVATION	AMOUNT PENETRATED	DISPOSITION	STAGE TO CORRECT
26	TOWER (HP)*	-19+00/2,600'R	631'	631'	HORIZONTAL / CONICAL	515'	116'	TO REMAIN	N/A
27	BUILDINGS (HP)*	0+48/2,500'R	553'	575'	HORIZONTAL	515'	50'	TO REMAIN	N/A
28	TERRAIN (HP)	32+68/3,100'R	556'	556'	HORIZONTAL	515'	41'	TO REMAIN	N/A
29	TERRAIN (HP)	66+50/5,300'R	606'	606'	CONICAL	563'	43'	TO REMAIN	N/A
30	BEACON/WINDCONE	9+11/348'L	351'	391'	TRANSITIONAL	372'	19'	TO REMAIN	N/A

HP = HIGH POINT OF OBSTRUCTION. STATION AND OFFSET ARE IN REFERENCE TO RW 01/19 CENTERLINE ALIGNMENT.

NOTE:
 * OBSTRUCTION IS LOCATED ON TERRAIN THAT ALSO PENETRATES THE PART 77 SURFACE.


BY	DATE	REVISION

STATE OF ALASKA
DEPARTMENT OF TRANSPORTATION
AND PUBLIC FACILITIES
CENTRAL REGION


TALKEETNA AIRPORT
 TALKEETNA, ALASKA
 AIRPORT LAYOUT PLAN
 AIRPORT AIRSPACE
 (F.A.R. PART 77)

DATE: 5/19/2020
 SHEET: 17 OF 20

Designed By: LEN
 Drawn By: ABC
 Checked By: MMS

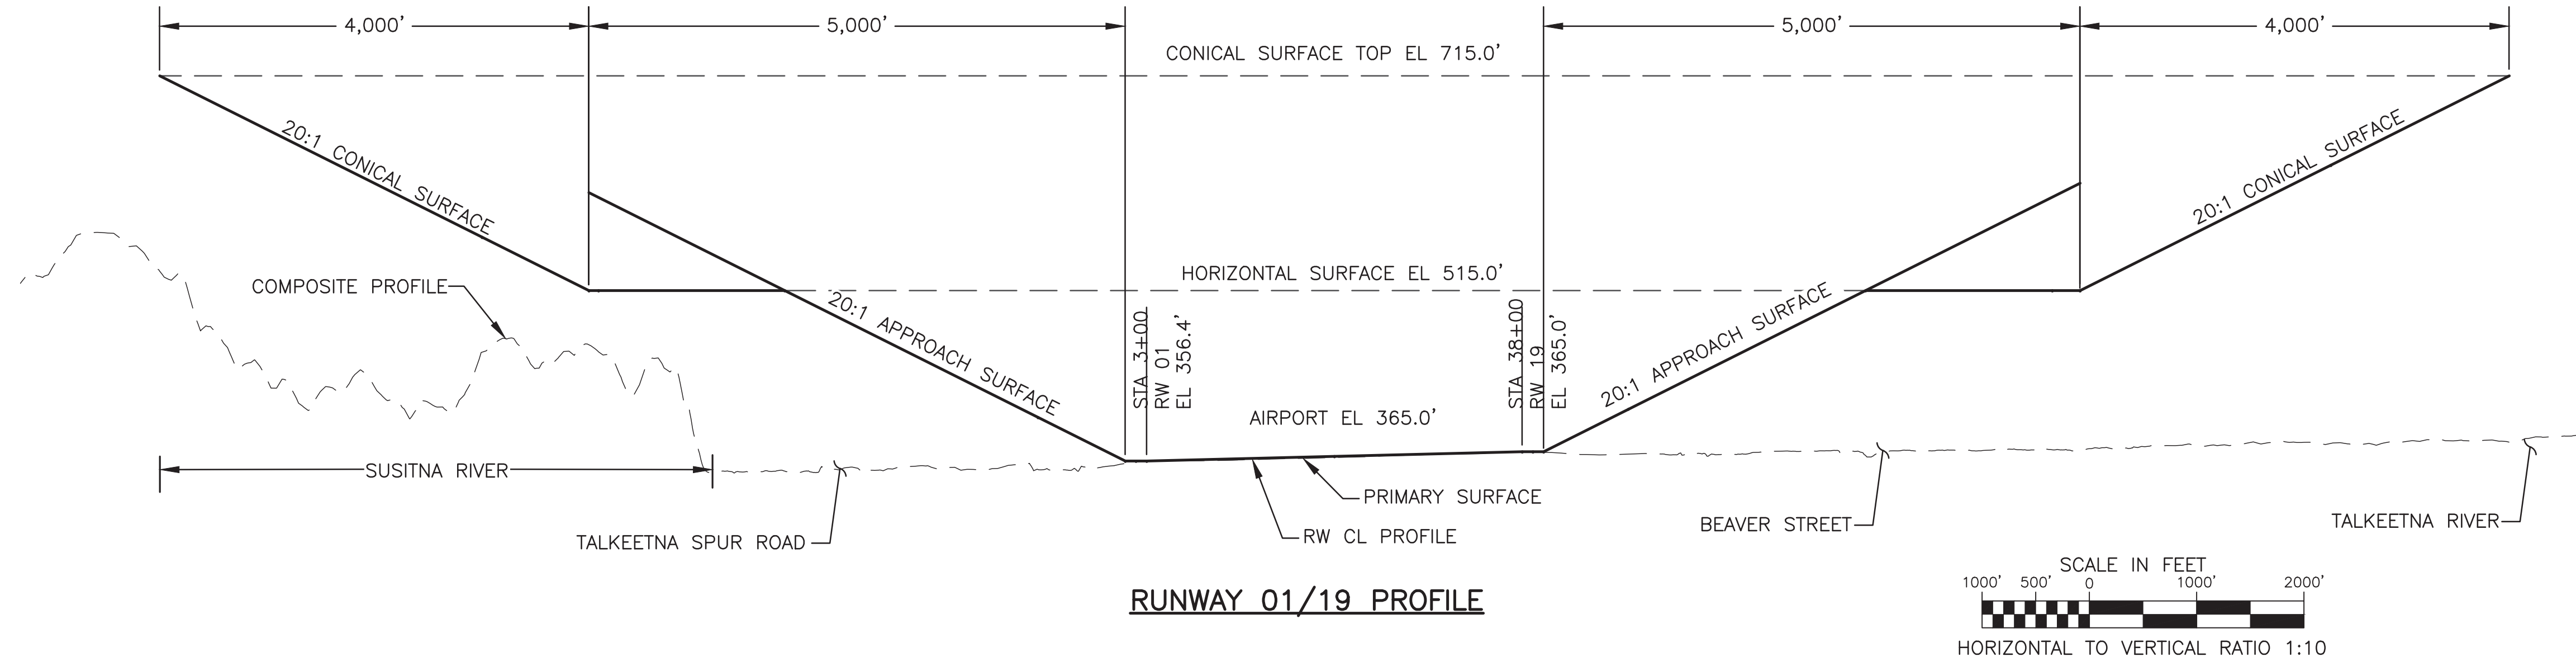

RUNWAY 01/19 PROFILE

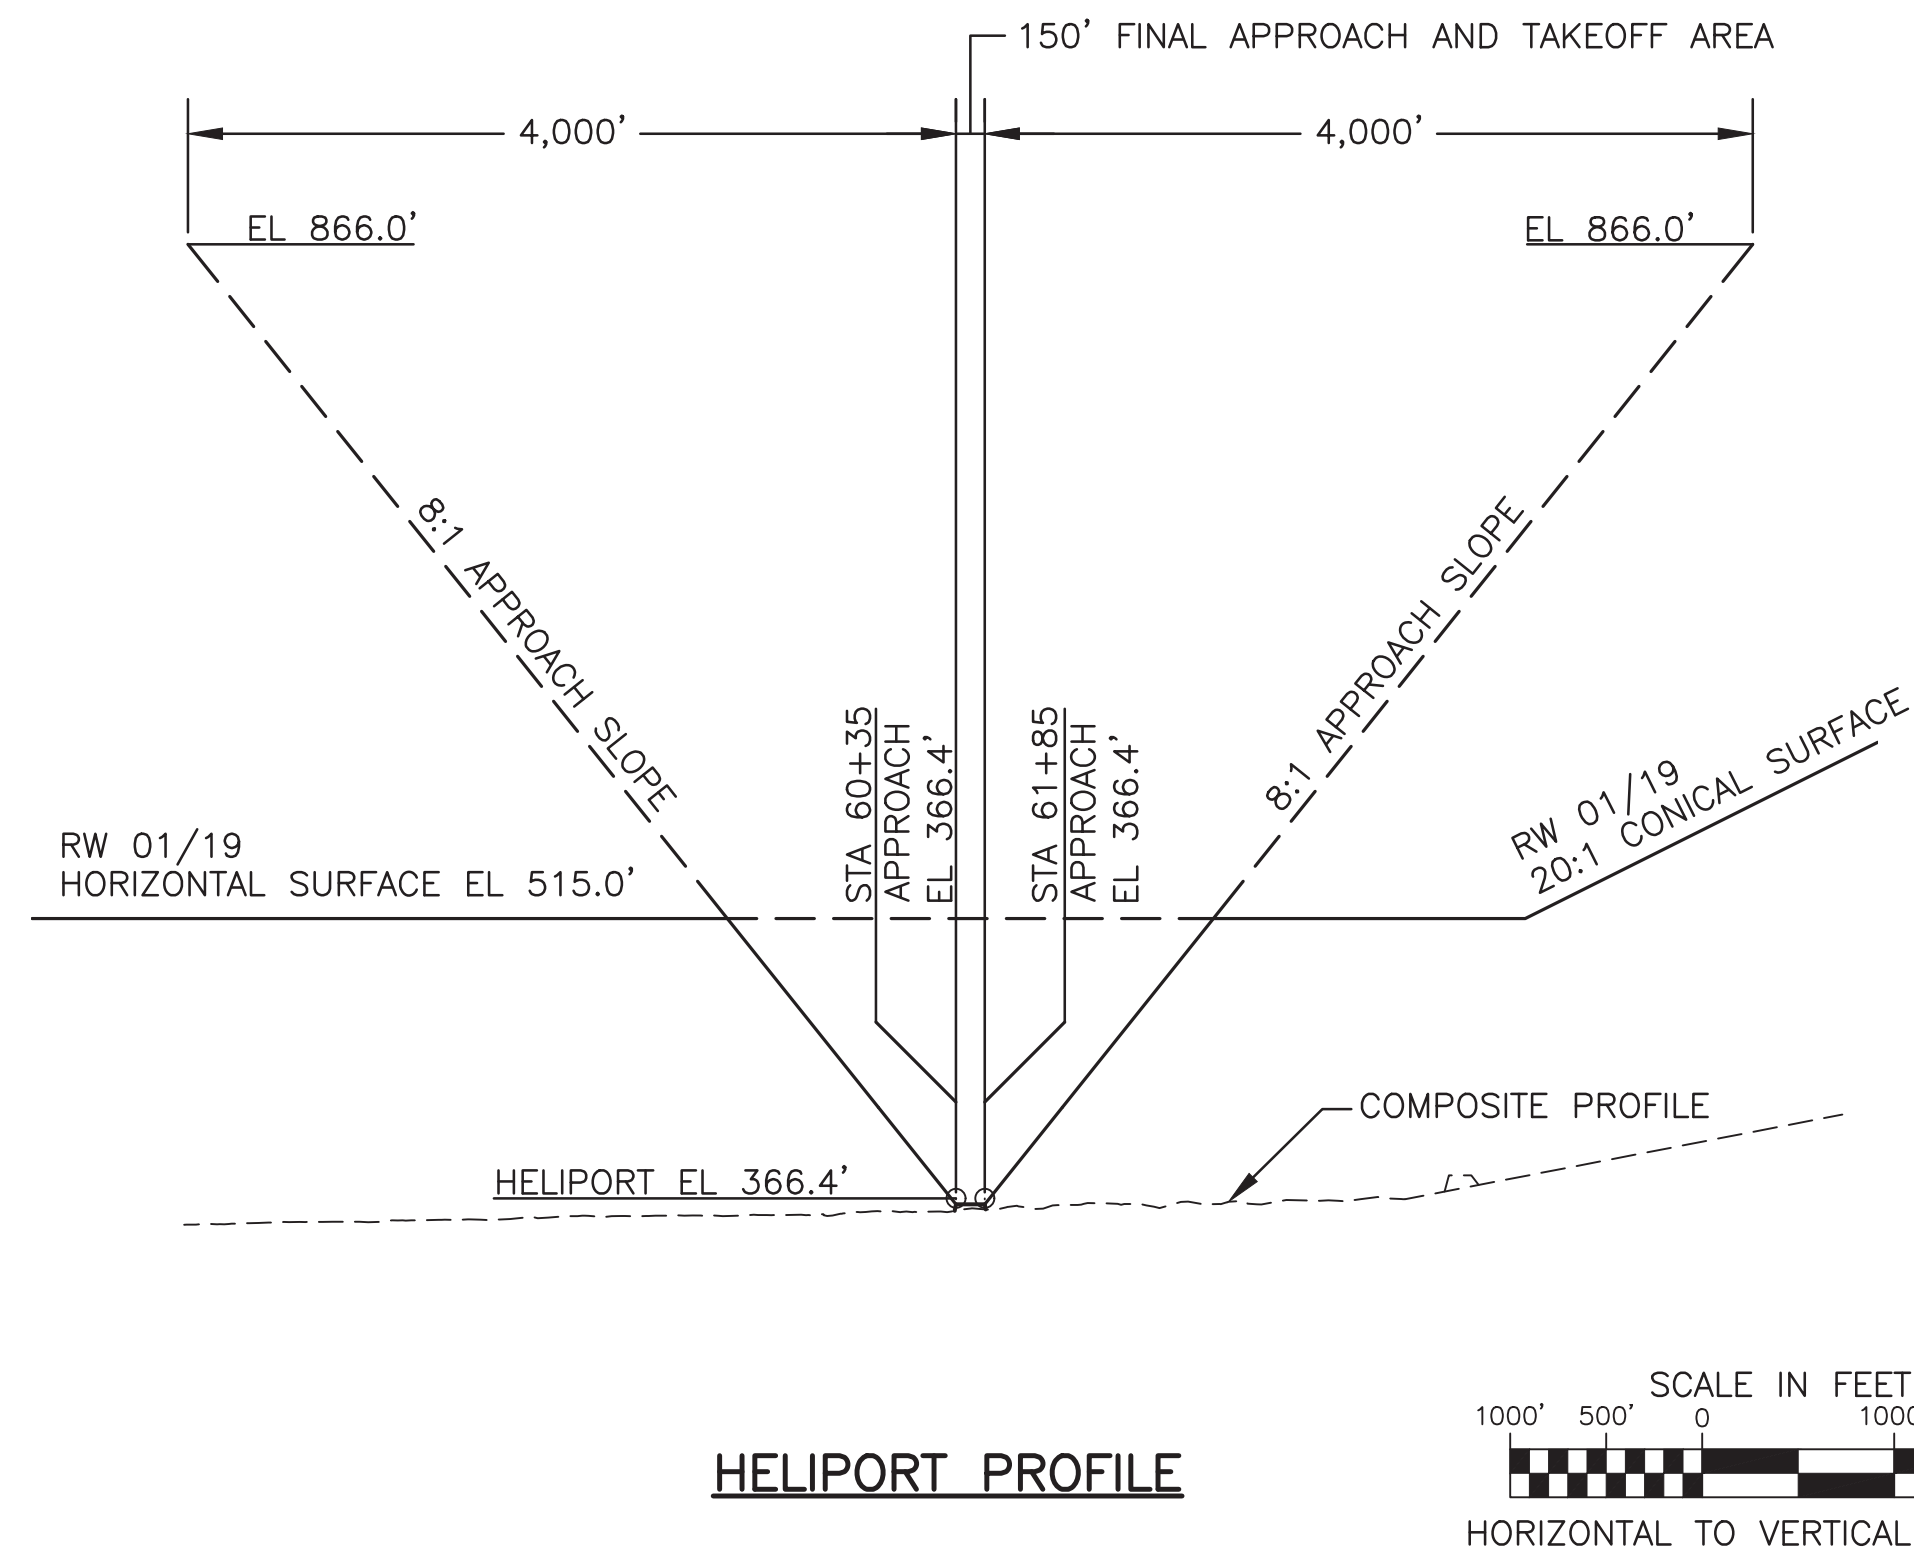

HELIPORT PROFILE

Date Plotted: 5/19/2020, 1:52 PM
 Layout Name: 18 PART 77 RW 19 AND HELIPORT
 File Name: U:\2019\2020\Talkeetna\Talkeetna\Uggs\CAs-B\11-ALP-2019\Sheets\ALP-TA-17-18_AIRSPACE_PART77.dwg

BY	DATE	REVISION




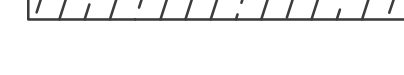

STATE OF ALASKA
 DEPARTMENT OF TRANSPORTATION
 AND PUBLIC FACILITIES
 CENTRAL REGION


TALKEETNA AIRPORT
 TALKEETNA, ALASKA
 AIRPORT LAYOUT PLAN
 AIRPORT AIRSPACE PROFILES
 (F.A.R. PART 77)
 RUNWAY 1-19 AND HELIPORT

DATE:
5/19/2020
 SHEET:
18
 OF
20

Designed By: LEN
 Drawn By: ABC
 Checked By: MMS
 Date: 5/19/2020, 3:15 PM
 Project Name: 19 LAND USE
 File Name: U:\2019\0528\Talketna\Drawings\CAs-B\11-ALP_2019\Sheet3\ALP-TA4-19_LAND_USE.dwg

LEGEND:

-  PRIVATE RESIDENTIAL / COMMERCIAL
-  GENERAL AVIATION
-  GOVERNMENT/INDUSTRIAL
-  COMMERCIAL AVIATION
-  NATIVE CORPORATION

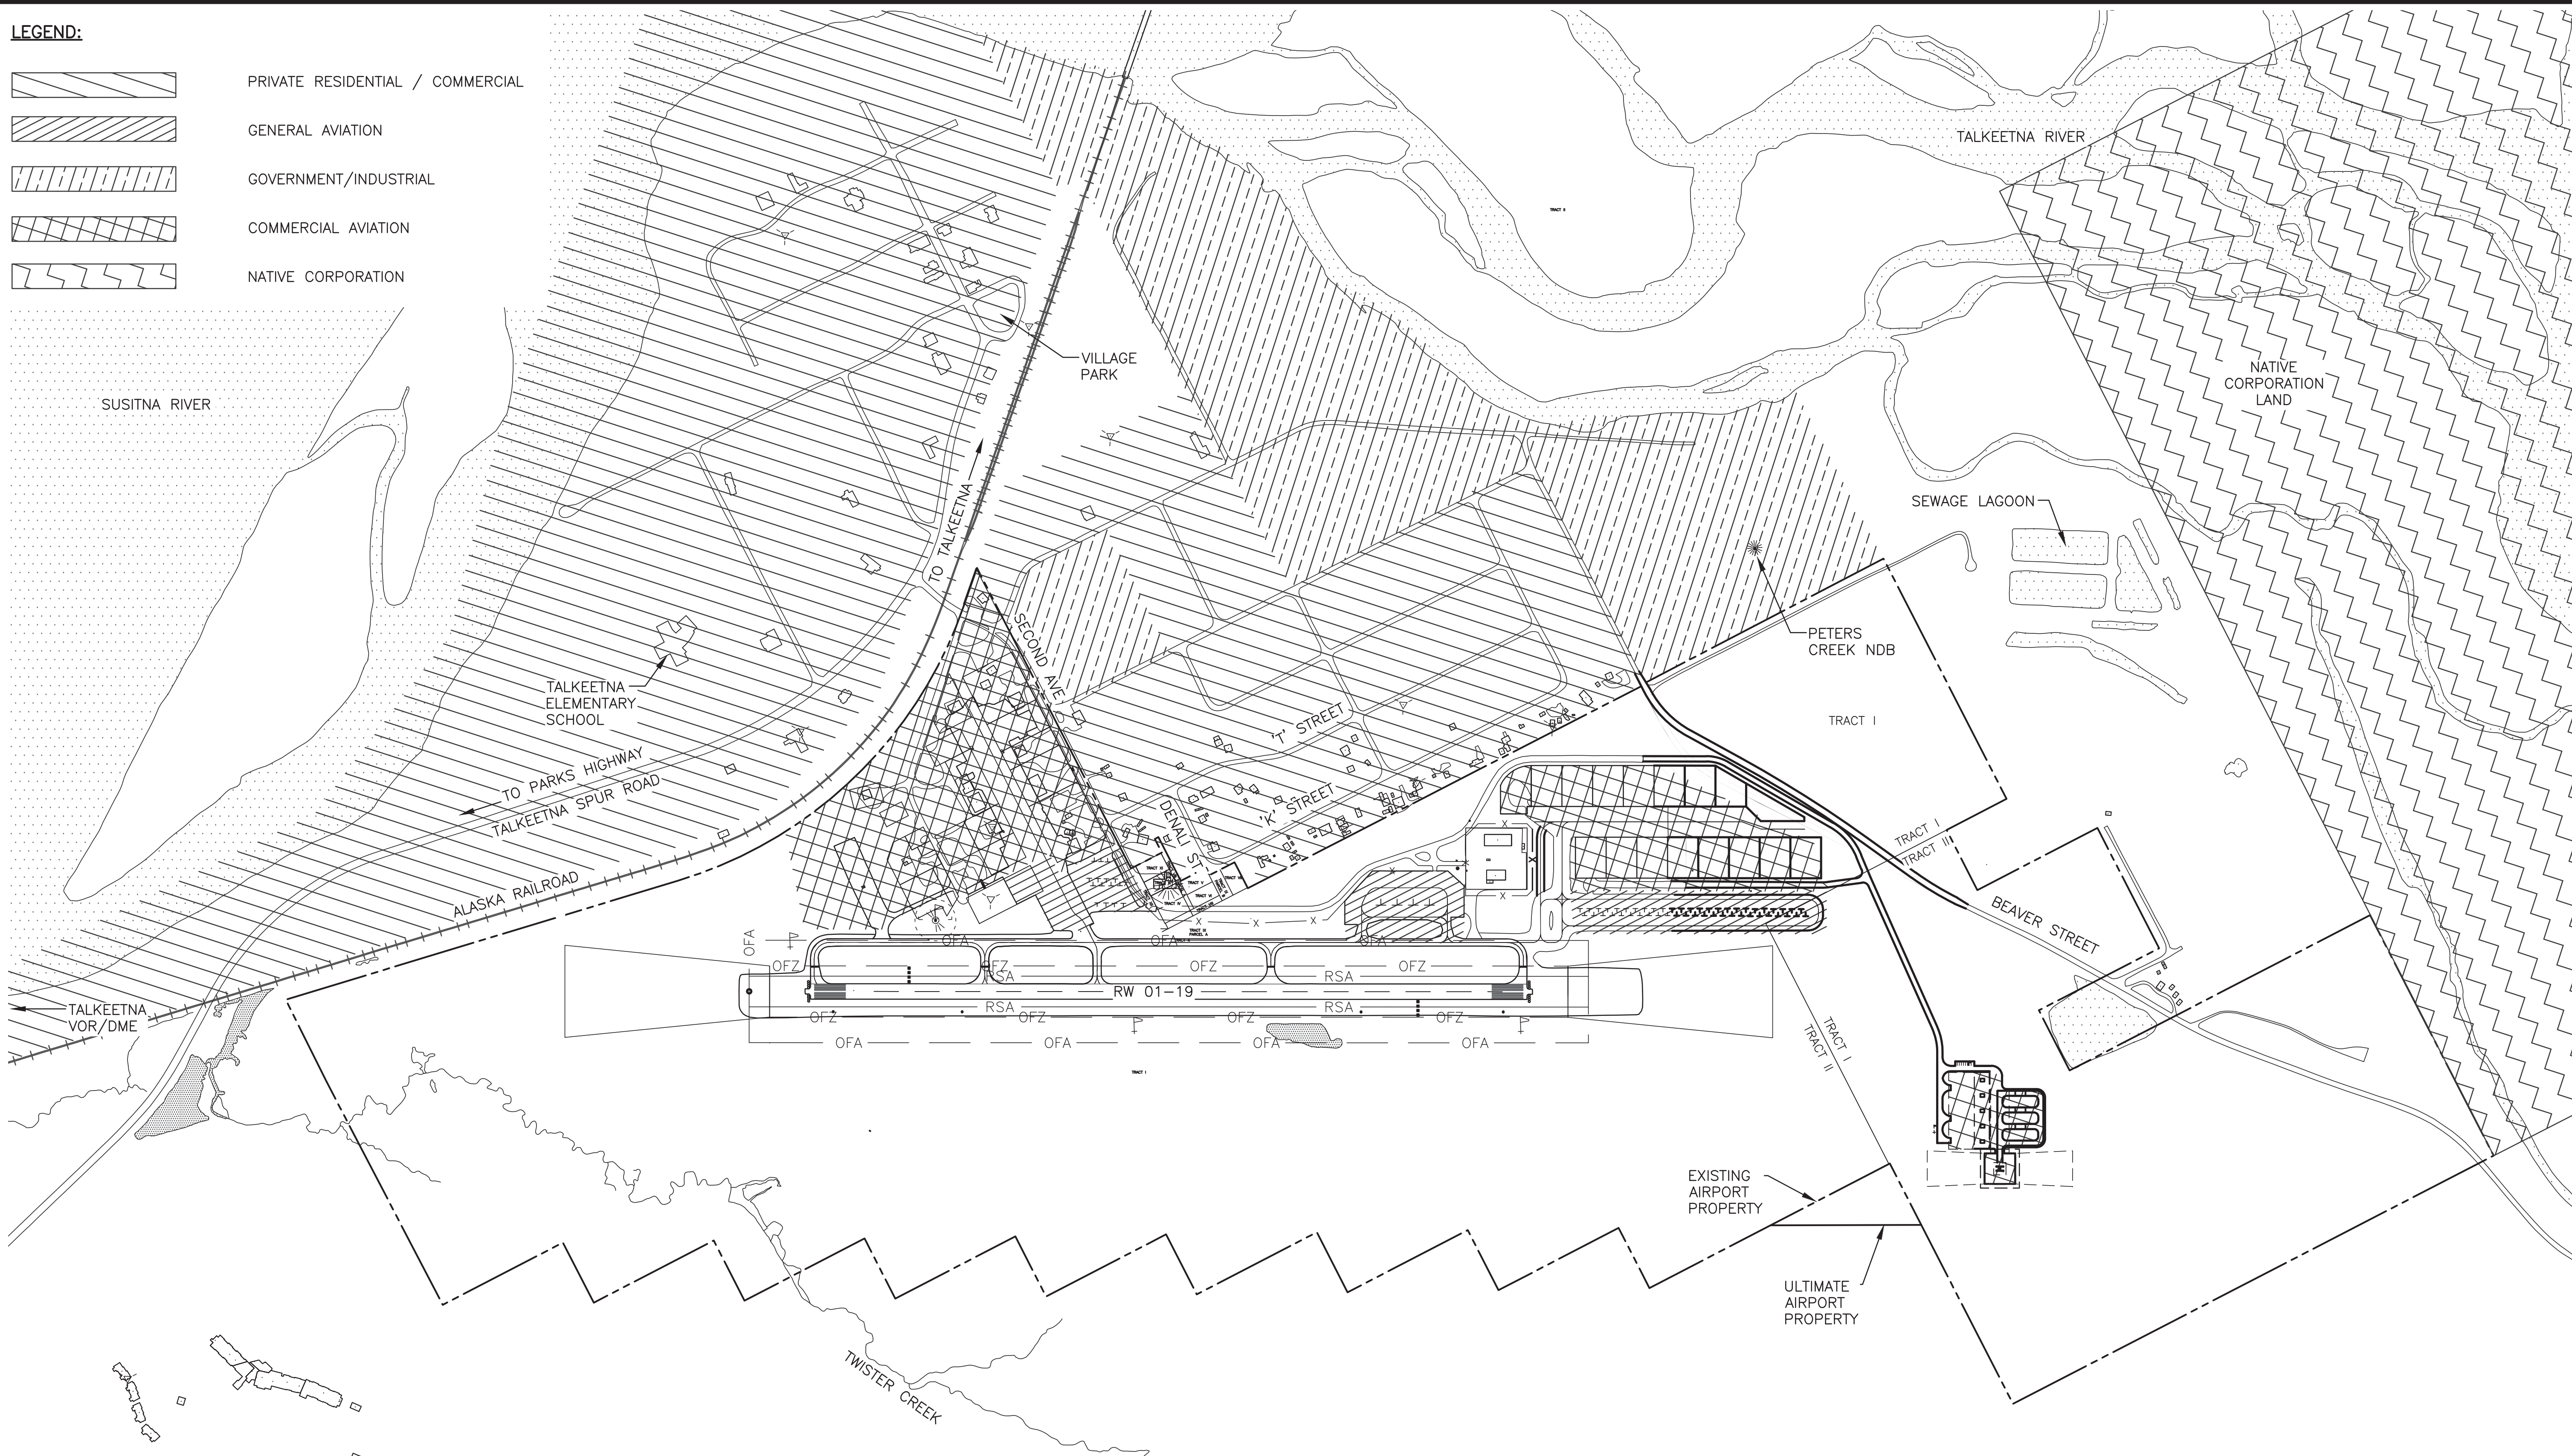

SUSITNA RIVER

VILLAGE PARK

TALKEETNA RIVER

NATIVE CORPORATION LAND

SEWAGE LAGOON

TALKEETNA ELEMENTARY SCHOOL

PETERS CREEK NDB

TRACT I

TO PARKS HIGHWAY
TALKEETNA SPUR ROAD

TO TALKEETNA

SECOND AVE

T STREET

DENALI ST

K STREET


ALASKA RAILROAD

TRACT I

TRACT III

BEAVER STREET


TALKEETNA VOR/DME

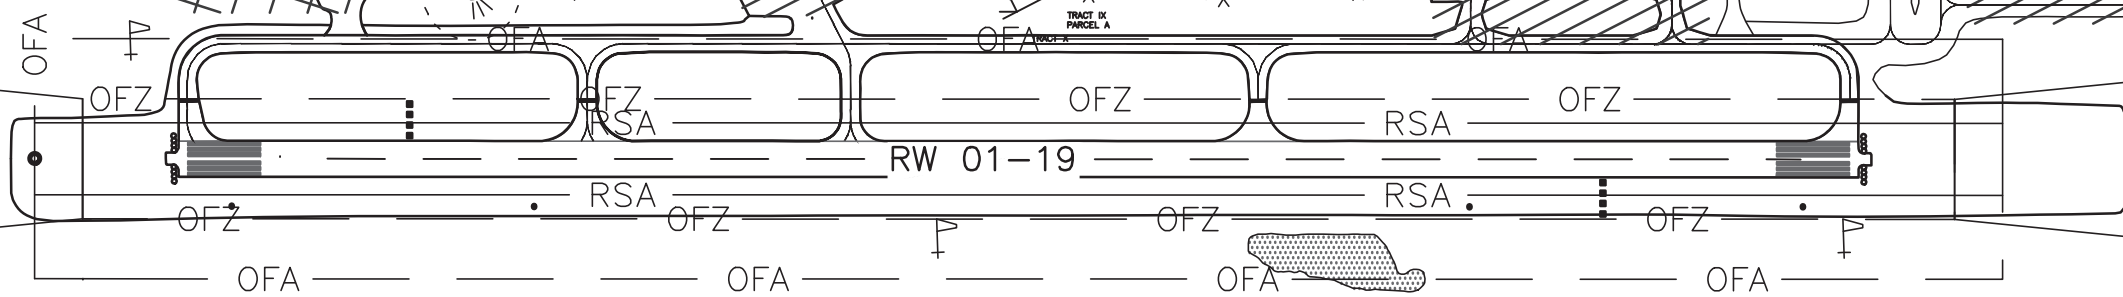

EXISTING AIRPORT PROPERTY

ULTIMATE AIRPORT PROPERTY

TWISTER CREEK

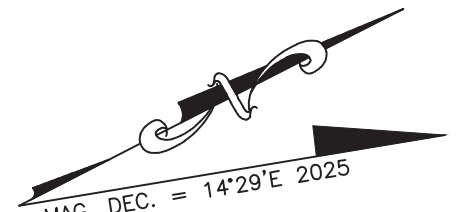

BY	DATE	REVISION


STATE OF ALASKA DEPARTMENT OF TRANSPORTATION AND PUBLIC FACILITIES CENTRAL REGION	
TALKEETNA AIRPORT TALKEETNA, ALASKA AIRPORT LAYOUT PLAN	
LAND USE	
DATE: 5/19/2020 SHEET: 19 OF 20	

Date: 15/19/2020, 4:05 PM
 User: 20 PROPERTY MAP
 File Name: U:\204700282\Talketna\Drawings\ALP-Talketna\2019\Sheet3\ALP-Talketna-20-PROPERTY_MAP.dwg
 Designed By: LEN
 Drawn By: ABC
 Checked By: MMS



PROPERTY STATUS

ID #	PARCEL	INTEREST	GRANTOR	GRANTEE	PARCEL SIZE	DATE ACQUIRED	RECORDED DOC NO.	ACQUIRED A.I.P. NO.
1	TRACT I	FEE SIMPLE TITLE UNDER SEC. 45 OMNIBUS ACT	UNITED STATES OF AMERICA	SOA	397.14 AC.±	10/1/1965	BK 33 PG 198	N/A
2	TRACT II	FEE SIMPLE TITLE	EUGENE H. JOHNSON AND DIANE K. JOHNSON	SOA DOT/PF	120.08 AC.±	4/28/1975*	BK 56 PG 644* & PG 652**	N/A
3	TRACT III	WARRANTY DEED	JAMES J. KELLARD AND SUSAN P. KELLARD	SOA DOT/PF	0.24 AC.±	7/20/1995	BK 154 PG 204	3-02-0287-03
4	TRACT IV	WARRANTY DEED	JAMES J. KELLARD AND SUSAN P. KELLARD	SOA DOT/PF	0.480 AC.±	7/20/1995	BK 154 PG 204	3-02-0287-03
5	TRACT V	WARRANTY DEED	MAURICE P. OSWALD	SOA DOT/PF	0.24 AC.±	10/2/1995	BK 155 PG 438	3-02-0287-03
6	TRACT VI	WARRANTY DEED	LEWIS E. DICKINSON	SOA DOT/PF	0.24 AC.±	10/2/1995	BK 155 PG 434	3-02-0287-03
7	TRACT VII	WARRANTY DEED	OTTO BAYER	SOA DOT/PF	0.24 AC.±	8/3/1995	BK 154 PG 467	3-02-0287-03
8	TRACT VIII	CORPORATION WARRANTY DEED	TRANSAC INC.	SOA DOT/PF	0.11 AC.±	9/16/1996	BK 164 PG 350	3-02-0176-02
9	TRACT VIII PARCEL A	CORPORATION WARRANTY DEED	TRANSAC INC.	SOA DOT/PF	0.18 AC.±	9/16/1996	BK 164 PG 350	3-02-0176-02
10	TRACT IX PARCEL A	(TO BE ACQUIRED)	MATANUSKA SUSITNA BOROUGH		0.094 AC.±			
11	TRACT IX PARCEL B	(TO BE ACQUIRED)	MATANUSKA SUSITNA BOROUGH		0.19 AC.±			
12	TRACT X	EASEMENT AND RESTRICTIVE COVENANT	MATANUSKA SUSITNA BOROUGH	SOA DOT/PF	0.005 AC.±	3/20/1995	BK 152 PG 339	
13	TRACT XI	WARRANTY DEED	JAMES J. KELLARD AND SUSAN P. KELLARD	SOA DOT/PF	0.29 AC.±	7/20/1995	BK 154 PG 202	3-02-0287-03
14	TRACT XII	(TO BE ACQUIRED)	MATANUSKA SUSITNA BOROUGH		0.23 AC.±			
15	TRACT XIII	FEE QUIT CLAIM DEED	UNIVERSITY OF ALASKA	SOA DOT/PF	2.51 AC.±	4/14/2011	2011-007348-0	3-02-0287-004-2010

* DECL. OF TAKING: 9/26/1974, ** FINAL JUDGEMENT: 4/28/1975

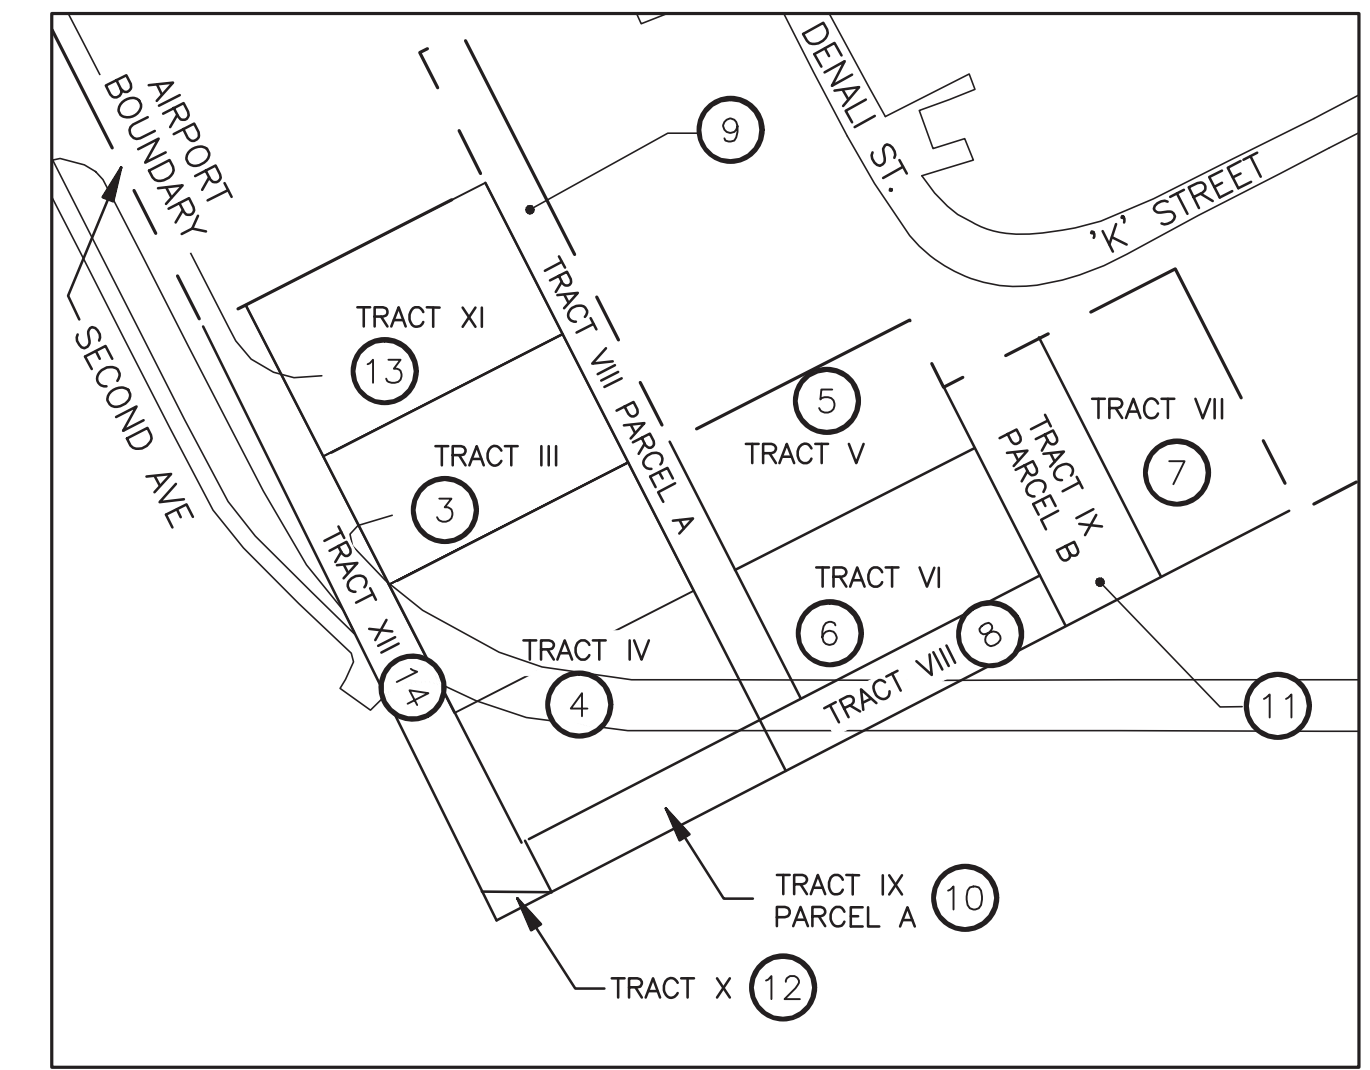

DETAIL

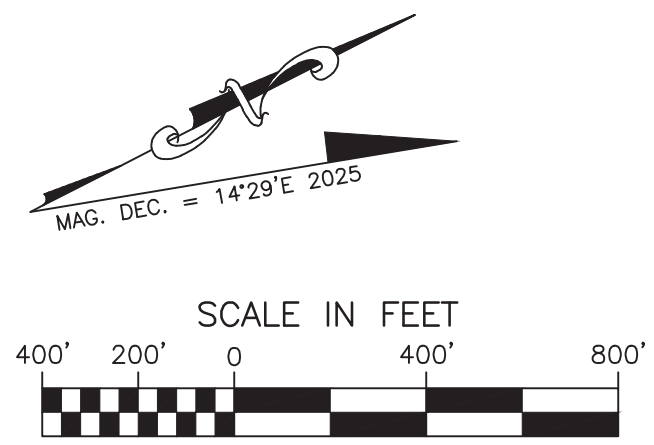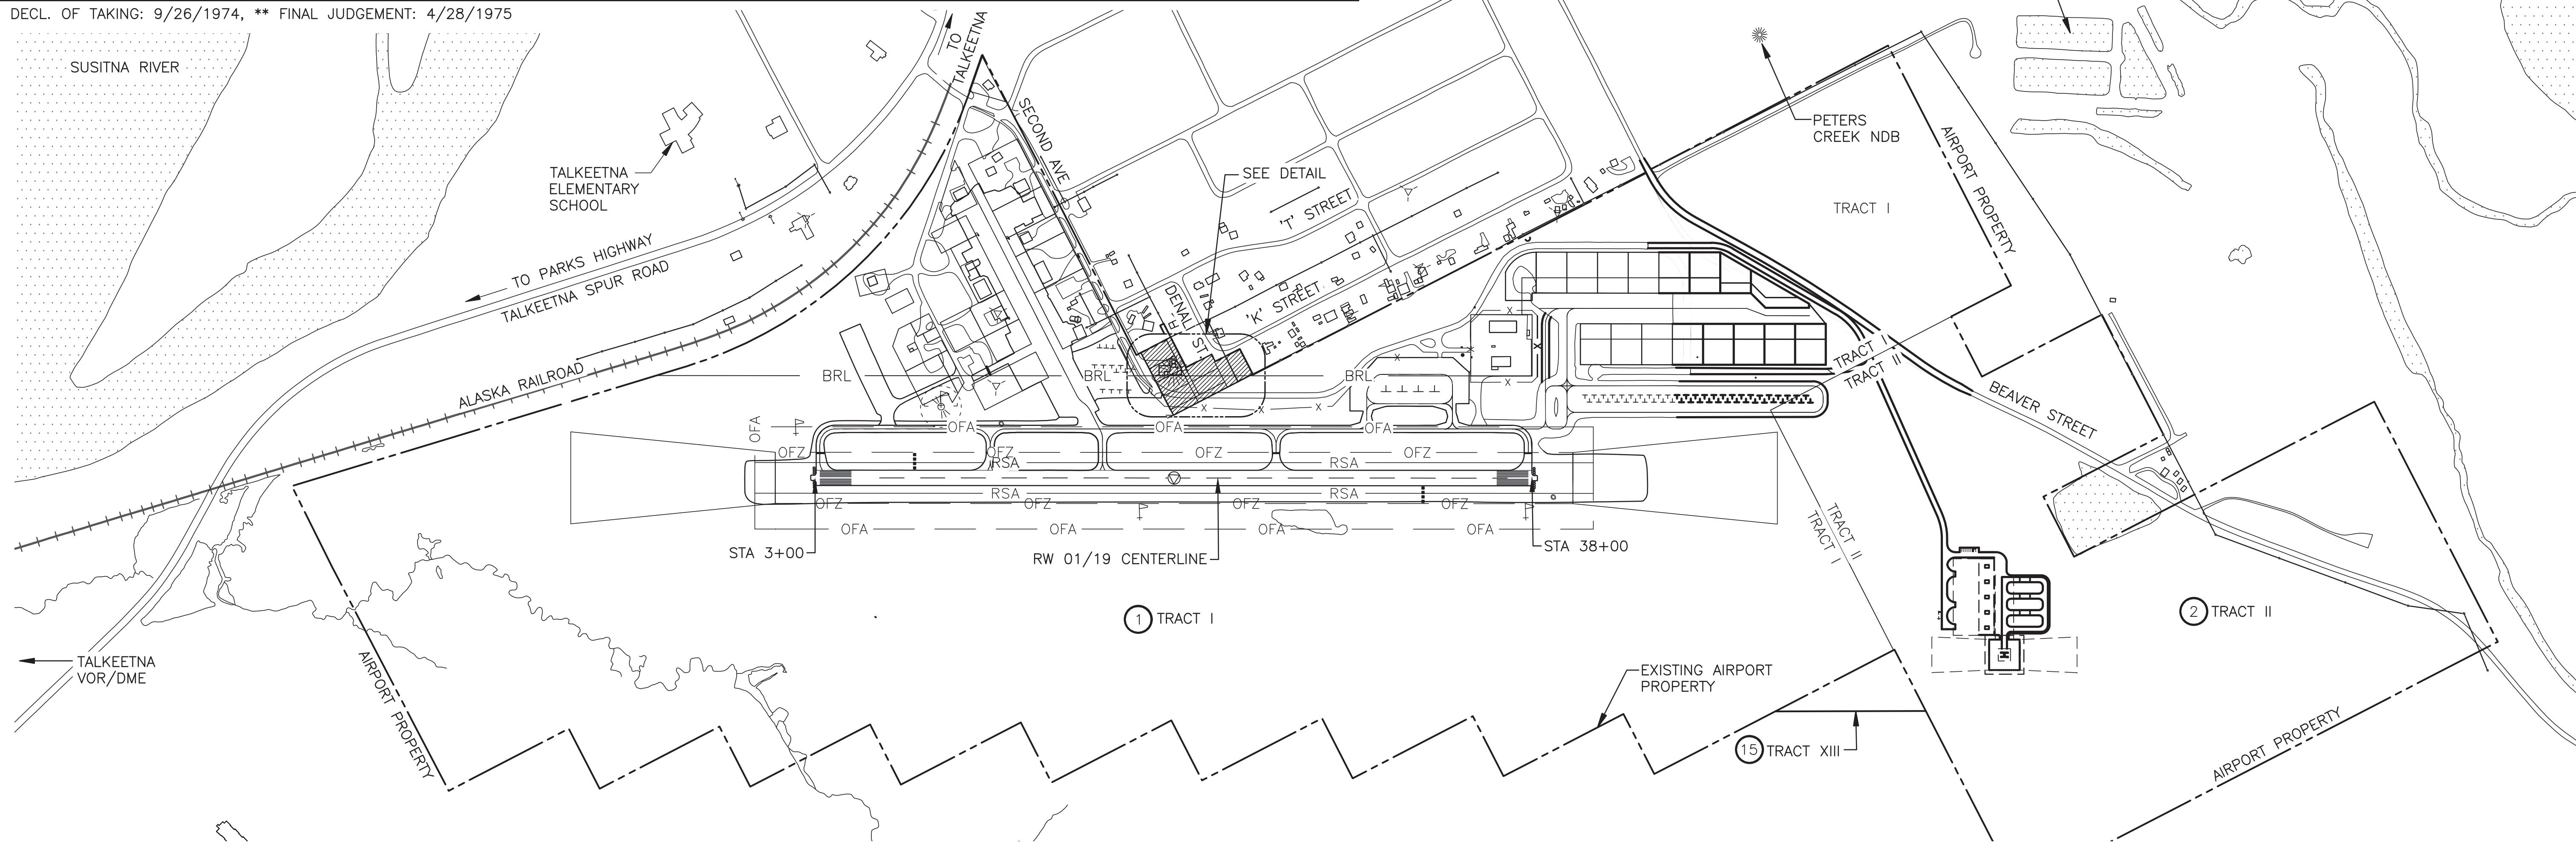

BY	DATE	REVISION

STATE OF ALASKA
DEPARTMENT OF TRANSPORTATION
AND PUBLIC FACILITIES
CENTRAL REGION

TALKEETNA AIRPORT
 TALKEETNA, ALASKA
 AIRPORT LAYOUT PLAN

PROPERTY MAP

DATE:
5/19/2020

SHEET:
20
OF
20